

PUBLIC LAND SURVEY MONUMENT RECORD

For Public Land Survey Corners in the


T. 1N., R. 13E.

CORNER CODE INDEX

	2	3	4	5	6	7	8	9	10	11	12	13	14	15	16	17	18	19	20	21	22	23	24	25
A																								
B	1	2	3	4	5	6	7	8	9	10	11	12	13	14	15	16	17	18	19	20	21	22	23	24
C																								
D	16	17	18	19	20	21	22	23	24	25	26	27	28	29	30	31	32	33	34	35	36	37	38	39
E																								

PLACE MONUMENT SYMBOL (◆) AT PROPER LOCATION ON ABOVE INDEX

EXAMPLE

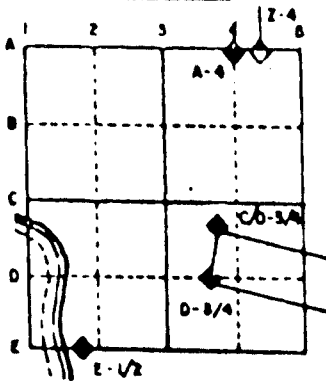

TURTLE TWP  
ROCK COUNTY WI

IF AVAILABLE  
STATE PLANE COORDINATES

North (Y) 233,159.20 Elev. (Z) \_\_\_\_\_  
East (X) 496,445.58 Zone 18N  
Hor. Datum COUNTY Vert. Datum \_\_\_\_\_

◆ CORNER MONUMENT

○ WITNESS MONUMENT

BEARINGS ARE BASED ON:

(B) Describe any record evidence, monument evidence, occupational evidence, testimonial evidence or any other material evidence you considered, and whether the monument was found or placed.

- 1835 WEST SOUTH SIDE SECTION 31 T2N R13E INTERSECTED RANGE LINE OF NORTH OF TEMPORARY 6 MILE 447.48'. SET POST AT INTERSECTION CORNER TOWNSHIPS 1&2 T12N & R13E IN PRAIRIE IN MOUND 6' SQUARE AND FOUR FEET HIGH. PIT SOUTH OF POST 9.24'.
- 1871 RUGER LA PRAIRIE TWP FIELD NOTES. SOUTH OF WEST LINE ON SW 1/4 OF SEC 31 ON A VAR 6-33 AT 2647.26' INTERSECTED SOUTH BOUNDARY LINE 9.24' WEST OF COR. FOUND REMAINS OF OLD STAKE AT COR. CORRECT VAR 6-45. SET CUT LIMESTONE. CALLS FOR 2647.26 VAR 6-45 TO W 1/4 COR & 2590.17 VAR 5-10 TO S 1/4 COR SEC 31 LA PRAIRIE TWP.
- 1876 RUGER VOL 2 PG 216 2596.11 TO S 1/4 COR SEC 36 & 2641.65 TO E 1/4 COR SEC 36.
- 1881 HOLMES VOL 2 PG 338 STONE MON. 2591.16 VAR 4-02 TO S 1/4 COR SEC 31, 2646.6 TO W 1/4 COR SEC 31, & VAR 4-16 FROM S 1/4 COR TO SE COR SEC 31.
- 1893 BLEEDORN VOL 2 PG 480 CALLS FOR A MON. BUT STATES NOTHING ABOUT IT. 2649.9 TO S 1/4 COR SEC 31 LA PRAIRIE TWP.
- 1936 SUNNY VOL 3 PG 296 FOUND 6X6 CUT LIMESTONE 43" LOW SET 2 1/4 X 3" CONC. FENCE POST ON TOP 3'-0" LONG. SET 1 1/2X7 IRON PIPE CAPPED ON TOP FLUSH WITH BLACKTOP PAVEMENT. REFERENCED SAME.
- 1948 SHIMEALL VOL 6 PG 335 & 357 SHIMEALL'S FIELD NOTES PG 61. TRANSCRIBED FIELD NOTES. CALLS FOR 2594 TO N 1/4 COR SEC 1.
- 1957 BATTERMAN VOL 3 PG 527 SEE VOL 3 PG 296 2637.97 TO N 1/4 COR SEC 1, 3085.10 TO E 1/4 COR SEC 1, ANGLE 91-36-20 AT NE COR SEC 1 FROM E 1/4 TO N 1/4 CORNERS SEC 1, & ANGLE 179-12 AT E 1/4 COR SEC 1 FROM SE TO NE CORNERS OF SEC 1.
- 1960 BATTERMAN VOL 4 PG 57 STATES NOTHING ABOUT MON. REFERENCED CORNER.
- 1979 BARNES VOL 5 PG 576 FOUND MON BOX. 2638.43 TO N 1/4 COR SEC 1 BELOIT TWP.
- 1984 BARNES VOL 6 PG 316 DOT INFORMATION. ALUM. MON. 214,498.03; 2,266,352.37.
- 1986 BARNES Z1 FOUND 1" PIPE IN MON. BOX @ CENTER OF PVMT. REF. SAME.
- 1989 BARNES VOL 6 PG 397 2594.32 TO S 1/4 COR SEC 36, 2645.08 TO E 1/4 CORNERS OF SEC 36 ROCK TWP, ANGLE OF 87-00-30 AT SE COR FROM S 1/4 COR TO E 1/4 CORNERS OF SECTION 36, SUNNY'S ANGLE 87-00, COMBS ANGLE 87-00-05, RUGER'S DISTANCE FROM S 1/4 TO SE CORNERS OF SEC 36 2596.11, SHIMEALL'S DISTANCE 2594.23 FROM S 1/4 TO SE CORNERS SEC 36, ANGLE OF 92-17-27 AT E 1/4 FROM SE COR TO W 1/4 CORNERS OF SEC 36, COMBS ANGLE OF 92-17-35 AT E 1/4 COR FROM SE TO W 1/4 CORNERS OF SECTION 36.

FOUND 1" PIPE IN MONUMENT BOX.

C) Was the corner restored through acceptance of (1) an obliterated evidence location, or, (2) a found perpetuated location?  
ACCEPTED FOUND PERPETUATED LOCATION.

I, Donald Barnes, hereby certify that the corner points as identified by the corner code index were, in a field survey on, Oct 14, 1994, established, re-established, monumented, re-monumented, recovered or restored as expressed below and in conformance with the regulations and rules as required in the current manual of survey instructions of the United States Department of Interior, Bureau of Land Management.

COUNTY SURVEYOR FILING DATA

Date of computer entry \_\_\_\_\_

Date microfilmed \_\_\_\_\_

Number of included sheets \_\_\_\_\_  
CORNER CODE

seal  
*Donald Barnes*  
6/12/95

EMBOSS LAND SURVEYOR SEAL

*Donald Barnes*  
6/22/95

