

PUBLIC LAND SURVEY MONUMENT RECORD

For Public Land Survey Corners in the


T. 1 N., R. 13 E.

CORNER CODE INDEX

	1	2	3	4	5	6	7	8	9	10	11	12	13	14	15	16	17	18	19	20	21	22	23	24	25
A																									
B																									
C																									
D																									
E																									
F																									
G																									
H																									
I																									
J																									
K																									
L																									
M																									
N																									
O																									
P																									
Q																									
R																									
S																									
T																									
U																									
V																									
W																									
X																									
Y																									

PLACE MONUMENT SYMBOL (●) AT PROPER LOCATION ON ABOVE INDEX

EXAMPLE

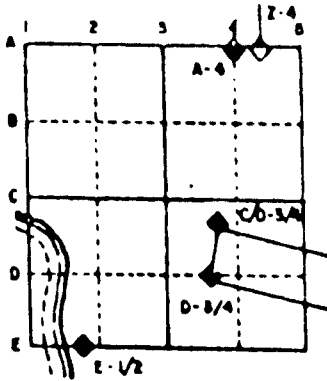

TURTLE TWP  
ROCK COUNTY WI

IF AVAILABLE  
STATE PLANE COORDINATES

North (Y) 232,804.95 Elev. (Z) \_\_\_\_\_  
East (X) 517,416.79 Zone \_\_\_\_\_  
Hor. Datum COUNTY Vert. Datum \_\_\_\_\_

◆ CORNER MONUMENT  
Fd 3/4" pin

○ WITNESS MONUMENT

Fd TRES IN VOL A pg 68

BEARINGS ARE BASED ON:

SHEET \_\_\_ OF \_\_\_

CORNER CODE:

A 17

(B) Describe any record evidence, monument evidence, occupational evidence, testimonial evidence or any other material evidence you considered, and whether the monument was found or placed.

- 1836 LYON INTERSECTED NORTH BOUNDARY & SET POST CORNER TO SEC 2 & 3 66.66' WEST OF CORNER TO SECTIONS 34&35. BUR OAK 16 S13E 709' NO OTHERS NEAR. APRIL 27TH 1836.
- 1861 RUGER VOL 1 PG 151 SET LIMESTONE 12X9X2 & SURROUNDED WITH 3 HARD HEAD STONES. 66.66' WEST OF SE COR SEC 34. 2642.97 TO N 1/4 COR SEC 2.
- 1861 RUGER VOL 1 PG 152 2667.06 TO N 1/4 COR SEC 3.
- 1935 SUNNY VOL 3 PG 269 FOUND LIMESTONE. 66.66 EAST(SHOULD BE WEST) OF NW COR SEC 2.
- 1963 BATTERMAN VOL 4 PG 68 FOUND 3/4" PIN AT NW COR SEC 2 66.65 WEST OF SW COR SEC 35. REFERENCED SAME.

FOUND 3/4" PIN AND TIES FROM VOL 4 PG 68.

C) Was the corner restored through acceptance of (1) an obliterated evidence location, or, (2) a found perpetuated location?  
ACCEPTED FOUND PERPETUATED LOCATION.

D) Describe any material discrepancy between the location of the corner as restored or reestablished and the location of that corner as previously restored or reestablished by distance and direction. Show the discrepancy on the plan view drawing under (a), above. Show the distances between the corner as previously restored or reestablished and (1) the corner as restored or reestablished, and (2) to at least 4 of the witness monuments shown on the drawing in (a), above.

(E) Was the corner reestablished through lost corner proportionate methods? If so, show the method, including the directions and distances to other public land survey corners used as evidence or used for proportioning the corner location.  
NO

I, Donald Barnes, hereby certify that the corner points as identified by the corner code index were, in a field survey on, 1994, established, re-established, monumented, re-monumented, recovered or restored as expressed below and in conformance with the regulations and rules as required in the current manual of survey instructions of the United States Department of Interior, Bureau of Land Management.

COUNTY SURVEYOR FILING DATA

Date of computer entry \_\_\_\_\_

Date microfilmed \_\_\_\_\_

Number of included sheets \_\_\_\_\_  
CORNER CODE

seal  
*Donald Barnes*  
7/12/95

EMBOSS LAND SURVEYOR SEAL

A-E 7.08 REQUIREMENT