
U.S.

SURVEY TUBLIC MONUMENT RECORD

For Public Land Survey Corners in the T. / N., R. 13 E

CORNER CODE INDEX

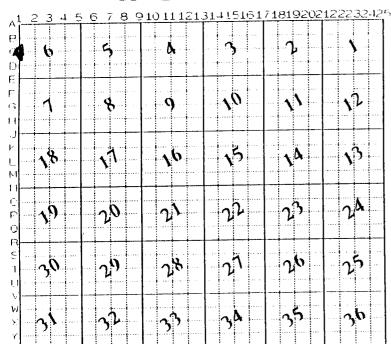

TURTLE ROCK COUNTY WI

TE AVAILABLE ROCK COUNTY COORDINATES PERFERRED

Morth 230,073.94 Elev.

East 496, 455,53

Hor. Datum Goowy Vert. Datum _

TRAVERSE (X) X GPS (X) BASED ON THE FOLLOWING CONTROL:

PLACE MONUMENT SYMBOL & LOCATION ON ABOVE INDEX

CORNER MONUMENT

O WITHESS MONUMENT

(a)

Fd MON BOX

SEE BELOIT CZ5 FOR TIES

BEARINGS ARE BASED ON:

FIELD BOOK PAGE #

SHOW A PLAN VIEW DRAWLING DEPICTING THE CORNER MOREMENT AND SUPRICULDING PHYSICAL FEATURES, INCLUDING THE EXCAVATION AREA AND DEPTH. THE CORNER MOREMENT AND SUPRICULDING PHYSICAL FEATURES, INCLUDING CHARGET PRIMARY AND DEPTH. THE ORIGINAL POINT.

THE FOLLOWING CHARGET STICES: 11 HAVE A LEAST TWO PREDICTEMENTED BREAK-COFF POINTS. 21 JE BROKET LEAVE A PERTAMENTLY MAGNETIZED FEMALIT AT THE ORIGINAL POINT.

THE PRIMARY HAVE BE USED TO ATTEMPT OF COURSE WHEN THE THIN OUR FOOD OF THE SAME ACE. IF THE CORNER IS OCCUPIED BY AN INFORMABIL BURDLESSIFIED CARLESTED AND ORDERS. DISTINCT INSURING HAVE USED TO ATTEMPT OF CHARGES WHILE BY A PERTAMENT OF THE CORNER OF THE CORNE

PLAINING & ZOUIDO COMMITTEE ADOPTED THE ABOVE FORM ON 12/2/1992 W1 ADMINISTRATIVE CODE A-E 7.08 REQUIREFERM

SHEET ___OF

- (B) Describe any record evidence, monument evidence, occupational evidence, testimonial evidence or any other material evidence you considered, and whether the monument was found or placed.
- 1865 LOCKE VOL 1 PG 235 FOUND LARGE RED HARD HEAD. CALLS FOR 2366.30 TO CENTER OF SEC 6 & 2634.26 TO SW COR SEC 6.
- 1882 HOLMES VOL 2 PG 357 FOUND LARGE READ HARD HEAD STONE. USED TO SUBDIVIDE SEC 6.
- 1936 SUNNY VOL 3 PG 296 FOUND LARGE READ HARD HEAD STONE BROKEN IN 2. SET 1 1/2" IRON PIPE, CAPPED ON TOP. REFERENCED SAME.
- 1957 BATTERMAN VOL 3 PG 527 FOUND PIPE SEE VOL 3 PG 296. 2674.36 TO CENTER OF SEC 1,2642.72 TO SW COR SEC 6,3085.10 TO NW COR SEC 6,& ANGLE OF 179-12 FROM SW COR TO NW COR OF SEC 6.
- 1960 BATTERMAN VOL 4 PG 57 REFERENCED MONUMENT.
- 1990 KREBS C25 BELOIT TWP. FOUND PIN IN MONUMENT BOX. REFERENCED SAME.
- 1991 COMBS CSM VOL 15 PG 180.

FOUND PIN IN MONUMENT BOX & KREBS' REFERENCE TIES.

- C) Was the corner restored through acceptance of (1) an obliterated evidence location, or, (2) a found perpetuated location?
 ACCEPTED FOUND PERPETUATED LOCATION.
- D) Describe any material discrepancy between the location of the corner as restored or reestablished and the location of that corner as previously restored or reestablished by distance and direction. Show the discrepancy on the plan view drawing under (a), above. Show the distances between the corner as previously restored or reestablished and (1) the corner as restored or reestablished, and (2) to at least 4 of the witness monuments shown on the drawing in (a), above.
- (E) Was the corner reestablished through lost corner proportionate methods? If so, show the method, including the directions and distances to other public land survey corners used as evidence or used for proportioning the corner location.

I, Donald Barnes, hereby certify that the corner points as identified by the corner code index were, in a field survey on,1994, established, re-established, monumented, re-monumented, recovered or restored as expressed below and in conformance with the regulations and rules as required in the current manual of survey instructions of the United States Department of Interior, Bureau of Land Management.

Seal

Date of computer entry

Date microfilmed

Number of included sheets

CORNER CODE