

# U.S. PUBLIC LAND SURVEY MONUMENT RECORD

For Public Land Survey Corners in the


T. 1 N., R. 3 E.

## CORNER CODE INDEX

	1	2	3	4	5	6	7	8	9	10	11	12	13	14	15	16	17	18	19	20	21	22	23	24	25
A																									
B																									
C	6																								
D																									
E					5																				
F																									
G																									
H	7																								
I																									
J																									
K																									
L	8																								
M																									
N																									
O																									
P	9																								
Q																									
R																									
S																									
T	30																								
U																									
V																									
W																									
X																									
Y	31																								
Z																									

PLACE MONUMENT SYMBOL (◆) AT PROPER LOCATION ON ABOVE INDEX

### EXAMPLE

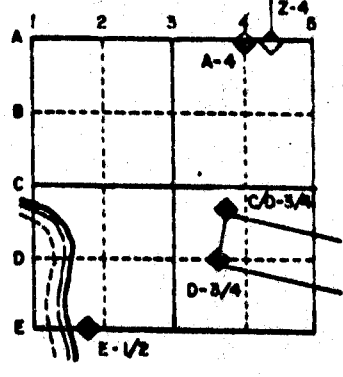

TURBULE

TWP  
ROCK COUNTY WI

### IF AVAILABLE STATE PLANE COORDINATES

North (Y) \_\_\_\_\_ Eleve. (Z) \_\_\_\_\_  
 East (X) \_\_\_\_\_ Zone \_\_\_\_\_  
 Hor. Datum \_\_\_\_\_ Vert. Datum \_\_\_\_\_

- (c.)      ◆ CORNER MONUMENT                      ○ WITNESS MONUMENT

See Reverse

BEARINGS ARE BASED ON:

## MICROFILMED


SHEET \_\_\_ OF \_\_\_

CORNER CODE: E7

PRESERVATION OF LANDMARKS

SECTION 59.635(7) WISCONSIN STATUTES


COUNTY Rock  
 TOWN Turtle  
 HIGHWAY Intersectn of creek Rd + Patrick Rd  
 SECTION NO. 5 3/4 cor  
 T. 1 N., R. 13 E.  
 TYPE OF LANDMARK 1/2" J.P.

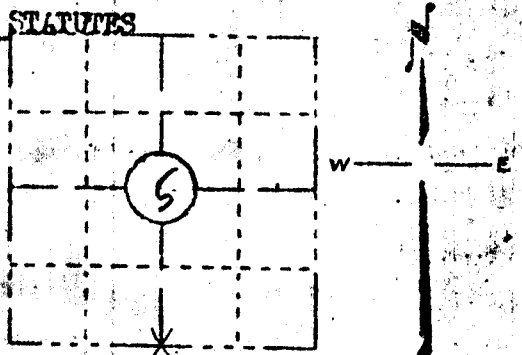

LOCATION INDICATED ON SKETCH X

LOCATION SKETCH

Ed. 1 1/2" J.P. next to large Rock. Pat. to J.P.

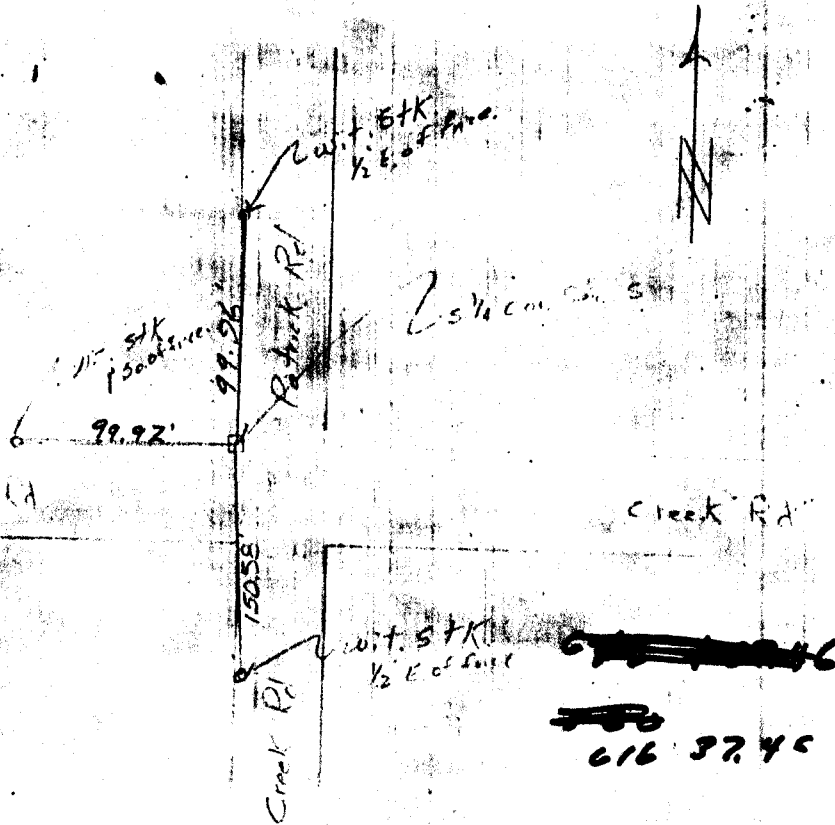

**N 46  
1985**

This space for copy of field notes or ties to the above described landmark

Field notes or records filed in book no. Notes pp 14

at the \_\_\_\_\_ office.

City of Janesville \_\_\_\_\_ Rock County.

located or established by T.H. Richard 7-15-58 1958

Title

County Clerk's Office \_\_\_\_\_ County, (Wis.) 58

to be used for record \_\_\_\_\_