

PUBLIC LAND SURVEY MONUMENT RECORD

For Public Land Survey Corners in the


T. 1N., R. 13E.

CORNER CODE INDEX

	1	2	3	4	5	6	7	8	9	10	11	12	13	14	15	16	17	18	19	20	21	22	23	24	25
A																									
B																									
C																									
D																									
E																									
F																									
G																									
H																									
I																									
J																									
K																									
L																									
M																									
N																									
O																									
P																									
Q																									
R																									
S																									
T																									
U																									
V																									
W																									
X																									
Y																									
Z																									

PLACE MONUMENT SYMBOL (◆) AT PROPER LOCATION ON ABOVE INDEX

EXAMPLE

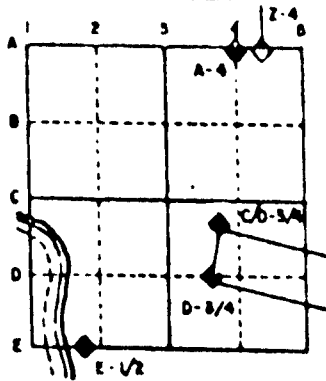

TURTLE TWP
ROCK COUNTY WI

IF AVAILABLE
STATE PLANE COORDINATES

North (Y) 227,431.18 Elev. (Z) _____

East (X) 496,427.56 Zone _____

Hor. Datum COUNTY Vert. Datum _____

◆ CORNER MONUMENT

○ WITNESS MONUMENT

BEARINGS ARE BASED ON:

(B) Describe any record evidence, monument evidence, occupational evidence, testimonial evidence or any other material evidence you considered, and whether the monument was found or placed.

- 1865 LOCKE VOL 1 PG 235 CORNER LOST. RAN UP TOWN LINE EQUALIZING DISTANCE & SET ON LINE TAMARACK STACK WITH OVAL HH 10X7X4 ON SOUTH & SMALL HH ON EAST 2634.26 TO W 1/4 COR SEC 6 & 2336.90 TO S 1/4 COR SEC 6.
- 1882 HOLMES VOL 2 PG 357 1920.6 TO A CORNER ON SOUTH LINE OF SW 1/4 OF SEC 6.
- 1936 SUNNY VOL 3 PG 296 DUG 6X8 6 DEEP & FOUND NOTHING. SET 3/8 PIN & REFERENCED SAME.
- 1957 BATTERMAN VOL 3 PG 527 PIPE. 2669.33 TO S 1/4 COR SEC 1, 2642.72 TO W 1/4 COR SEC 6, ANGLE OF 91-36-~~20~~ FROM S 1/4 COR SEC 1 TO W 1/4 COR SEC 6.
- 1960 BATTERMAN VOL 4 PG 57 REFERENCED CORNER.
- 19?? BATTERMAN VOL 6 PG 328 FOUND IRON ROD & REFERENCED SAME. 2669.33 TO S 1/4 COR SEC 1.

FOUND CAST IRON MONUMENT. NO-36-22E 2642.90 TO W 1/4 COR SEC 6 & SO-41-23W 2642.71 TO W 1/4 COR SEC 7. CORNER IS 1.92' EAST OF A LINE BETWEEN THE W 1/4 COR SEC 6 AND THE W 1/4 COR SEC 7.

C) Was the corner restored through acceptance of (1) an obliterated evidence location, or, (2) a found perpetuated location?
ACCEPTED FOUND PERPETUATED LOCATION.

D) Describe any material discrepancy between the location of the corner as restored or reestablished and the location of that corner as previously restored or reestablished by distance and direction. Show the discrepancy on the plan view drawing under (a), above. Show the distances between the corner as previously restored or reestablished and (1) the corner as restored or reestablished, and (2) to at least 4 of the witness monuments shown on the drawing in (a), above.

(E) Was the corner reestablished through lost corner proportionate methods? If so, show the method, including the directions and distances to other public land survey corners used as evidence or used for proportioning the corner location.

NO

I, Donald Barnes, hereby certify that the corner points as identified by the corner code index were, in a field survey on, 1994, established, re-established, monumented, re-monumented, recovered or restored as expressed below and in conformance with the regulations and rules as required in the current manual of survey instructions of the United States Department of Interior, Bureau of Land Management.

seal

Donald Barnes

7/12/95

COUNTY SURVEYOR FILING DATA

Date of computer entry _____


Date microfilmed _____

Number of included sheets _____
CORNER CODE

EMBOSS LAND SURVEYOR SEAL

A-E 7.08 REQUIREMENT

E1

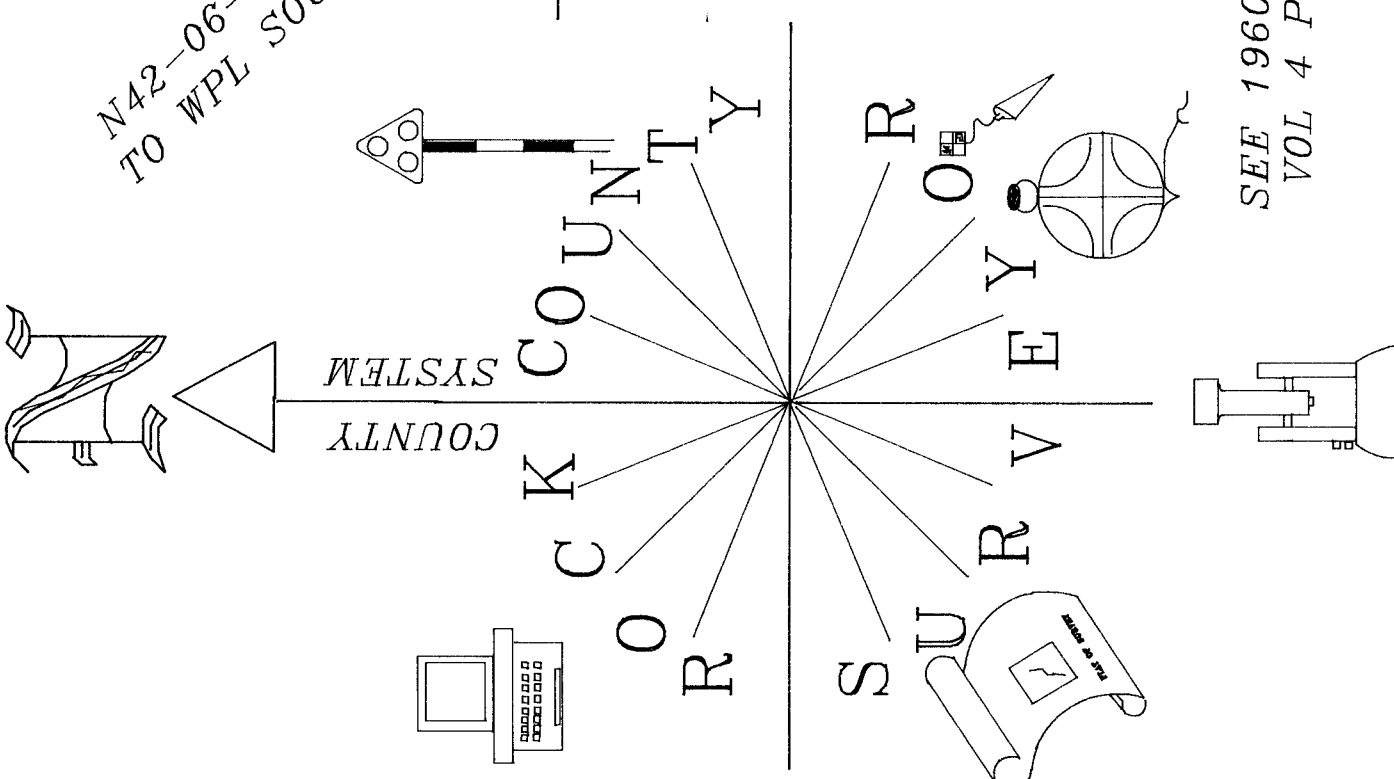

N42-06-59W 6,526
TO WPL SOUTH STACK

N0-36-23E 2642.90
TO W 1/4 COR SEC 6

S88-25-54E 20,215
TO DURST TANK

SW COR
SEC 6

FD CI

S89-24-59E 2339.18
TO S 1/4 COR SEC 6

S62-17-35E 37.64

S0-41-23W 2642.71
TO W 1/4 COR SEC 7

20MZ 1958
RESET 1960
DISK IN CULVERT

CTH "G"

SEE 1960 TIES
VOL 4 PG 57

Donald Barnes
7/12/95