

PUBLIC LAND SURVEY MONUMENT RECORD

For Public Land Survey Corners in the


T. 1N., R. 13E.

CORNER CODE INDEX

	1	2	3	4	5	6	7	8	9	10	11	12	13	14	15	16	17	18	19	20	21	22	23	24	25
A																									
M																									
L	6																								
D		5																							
E			4																						
F				3																					
G					2																				
N																									
J																									
K																									
L																									
M																									
N																									
U																									
P	9																								
Q		20																							
H			21																						
3				22																					
Y	30																								
U		29																							
V			28																						
W				27																					
X					26																				
Y						25																			
Z							31																		
								32																	
									33																
										34															
											35														
												36													

PLACE MONUMENT SYMBOL (●) AT PROPER LOCATION ON ABOVE INDEX

EXAMPLE

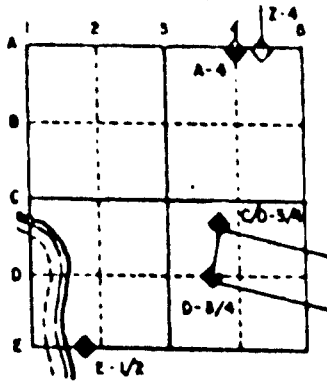

TURTLE TWP
ROCK COUNTY WI

IF AVAILABLE
STATE PLANE COORDINATES

North (Y) 227,198.38 Elev. (Z) _____
 East (X) 517,368.23 Zone _____
 Hor. Datum COUNTY Vert. Datum _____

◆ CORNER MONUMENT

○ WITNESS MONUMENT

BEARINGS ARE BASED ON:

SHEET _____ OF _____

E17

CORNER CODE: _____

(B) Describe any record evidence, monument evidence, occupational evidence, testimonial evidence or any other material evidence you considered, and whether the monument was found or placed.

1836 LYON SET POST CORNER TO SECTIONS 2,3,10&11 BUR OAK 8 N55W 22 & BUR OAK 16 S 30 1/2W 89. CALLS FOR 2647.92 TO S 1/4 COR SEC 3 & 2649.24 TO S 1/4 COR SEC 2.
1988 LEE MAP #12362 CALLS FOR 2661.39 TO S 1/4 COR SEC 3.
1989 COMBS CSM V 14 PG 102 2680.25 TO E 1/4 COR SEC 3.

FOUND PIPE.

C) Was the corner restored through acceptance of (1) an obliterated evidence location, or, (2) a found perpetuated location?

ACCEPTED FOUND PERPETUATED LOCATION.

D) Describe any material discrepancy between the location of the corner as restored or reestablished and the location of that corner as previously restored or reestablished by distance and direction. Show the discrepancy on the plan view drawing under (a), above. Show the distances between the corner as previously restored or reestablished and (1) the corner as restored or reestablished, and (2) to at least 4 of the witness monuments shown on the drawing in (a), above.

(E) Was the corner reestablished through lost corner proportionate methods? If so, show the method, including the directions and distances to other public land survey corners used as evidence or used for proportioning the corner location.

NO

I, Donald Barnes, hereby certify that the corner points as identified by the corner code index were, in a field survey on, 1994, established, re-established, monumented, re-monumented, recovered or restored as expressed below and in conformance with the regulations and rules as required in the current manual of survey instructions of the United States Department of Interior, Bureau of Land Management.

seal

7/13/95
Donald Barnes

COUNTY SURVEYOR FILING DATA

Date of computer entry _____

Date microfilmed _____

Number of included sheets _____

CORNER CODE

EMBOSS LAND SURVEYOR SEAL

A-E 7.08 REQUIREMENT

E17