
U.S. PUBLIC LAND SURVEY MONUMENT RECORD

T. N., R. 12 E 4th P.M.

For Public Land Survey Corners in: WI ADMINISTRATIVE CODE A-E 7.08 REQUIREMENT

CORNER CODE INDEX

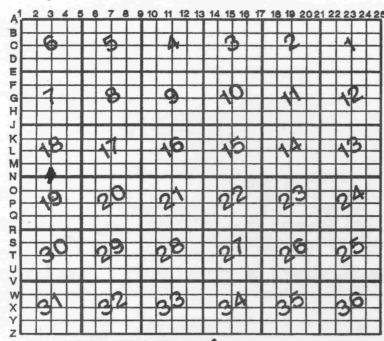

ROCK COUNTY, WI

IF AVAILABLE ROCK COUNTY COORDINATES PERFERRED

North 217, 290, 83 Elev.

East 467, 022,96

Hor. Datum COUNTY Vert. Datum LATITUDE _____ ELLIPS. HT.

LONGITUTE

ELLIPS. DATUM

NAD83(91) __ COUNTY __ LIST____

GPS (X) __ TRAVERSE (X) __ BASED ON THE FOLLOWING CONTROL:

PLACE MONUMENT SYMBOL
LOCATION ON ABOVE INDEX

◆CORNER MONUMENT

WITNESS MONUMENT

BEARINGS ARE BASED ON:

(a)

FIELD BOOK __ _PAGE # _ SHOW A PLAN VIEW DRAWING DEPICTING THE CORNER MONUMENT AND SURROUNDING PHYSICAL FEATURES, INCLUDING THE EXCAVATION AREA AND DEPTH. PLANNING & ZONING COMMITTEE ADOPTED THE ABOVE FORM ON 12/2/1982

CORNER CODE N-

BE562

(B) Describe any record evidence, monument evidence, occupational evidence, testimonial evidence or any other material evidence you considered, and whether the monument was found or placed.

1834 HARRISON WEST BET. SECS 18 & 19 ON RAND.

2640 TEMPY 1/4 SEC COR. 3630 LEAVE PRAIRIE & ENTER TIMBER

5197.5 INT. WEST BOUNDARY 59.4' SOUTH OF POST IN EAST EDGE OF

MARSH {SET COR TO SEC 18 & 19 MARKED POST.

LAND BOUNDARY 1ST RATE PRAIRIE FOR 1ST 3630' RUN. BOUNDARY 2ND RATE ? BURR & RED OAK TIMBER.

COR EAST
QUARTER SEC COR ON SUMMIT OF RIDGE CRS S.W. SET POST &
MOUND

5197.5 SEC COR.

2557.5

1960 BATTERMAN VOL 4 PG 110 SET R/R & REFERENCED SAME. N/S 198,302.87; E/W 2,237,107.47 WPL


1975 SPRAGUE MAP #427 N/S 198,302.87; E/W 2,237,107.47,S88-53-06E 1329.98 TO N 1/16TH COR OF NE 1/4 COR SEC 19,S88-53-18E 1329.98 FROM N 1/16TH COR OF NE 1/4 COR SEC 19 TO NE COR SEC 19,&N88-53-10W 2497.15 TO NW COR SEC 19.

FD PK.

- C) Was the corner restored through acceptance of (1) an obliterated evidence location, or, (2) a found perpetuated location?
 PK IS ON LINE WITH SE COR SEC 18 AND CUT LIMESTONE AT THE SE COR SEC 13 AND AT SINGLE PROPORTIONATE DISTANCE. DID NOT ACCEPT NOR REJECT LOCATION.
- D) Describe any material discrepancy between the location of the corner as restored or reestablished and the location of that corner as previously restored or reestablished by distance and direction. Show the discrepancy on the plan view drawing under (a), above. Show the distances between the corner as previously restored or reestablished and (1) the corner as restored or reestablished, and (2) to at least 4 of the witness monuments shown on the drawing in (a), above.
- (E) Was the corner reestablished through lost corner proportionate methods? If so, show the method, including the directions and distances to other public land survey corners used as evidence or used for proportioning the corner location.

 PROBABLY.
- I, Donald Barnes, hereby certify that the corner points as identified by the corner code index were, in a field survey on, established, reestablished, monumented, re-monumented, recovered or restored as expressed below and in conformance with the regulations and rules as required in the current manual of survey instructions of the United States Department of Interior, Bureau of Land Management.

	.R	COUNTY SURVEYOR FILING DATA	
seal 0279,1998		Date of computer entry	
		Date microfilmed	
Vonald Fours		Number of included sheets	
MBOSS LAND SURVEYOR SEAL A-1	E 7.08	REQUIREMENT 3	

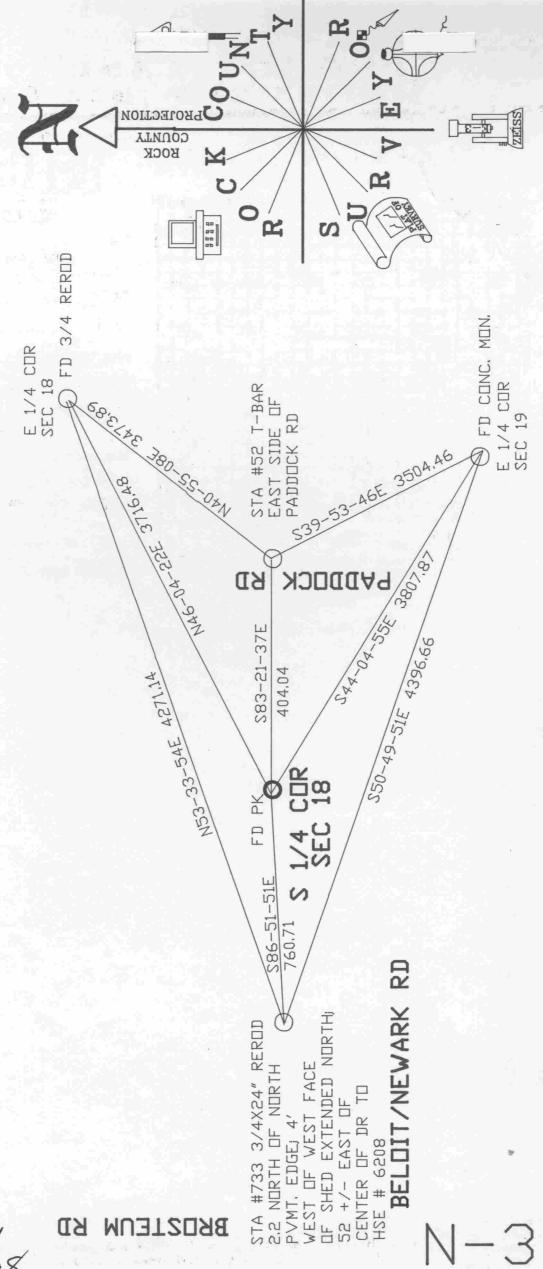

Donald Barnes Oct 9, 1998