

BE582

(B) Describe any record evidence, monument evidence, occupational evidence, testimonial evidence or any other material evidence you considered, and whether the monument was found or placed.

1834 HARRISON, ORIGINAL SURVEYOR

WEST BETWEEN SEC 19 & 30
2640 TEMP 1/4 SEC COR.
3966.6 BROOK 5.28' CRS S
5208.72 INT. W. BOUNDARY 50.16 SOUTH OF POST {COR TREES TO 19 & 30 BUR OAK 8 N49E 29?, BURR OAK 8 S70E ?

EAST COR BETWEEN 19 & 30
2568.72 QUARTER SECTION CORNER QUARTER SEC COR. RED OAK 20 N44E 31, RED OAK 12 N78W 350.2568.72' TO SW COR SEC 19 & 2640 TO S 1/4 COR SEC 19.

5208.72 SEC COR.

1983 LEUENBERGER MAP #14006 5/8" PIN AT CORNER. 2539.63' TO SW COR SEC 19.

FOUND 3/4" PIN 5.5 SOUTH OF NORTH PVMT. EDGE & ABOUT 48' WEST OF WEST POWER LINE OF N/S HIGH VOLTAGE TOWERS. PIN IS ON LINE WITH THE NE COR SEC 30 AND THE CUT LIMESTONE AT THE SE COR SEC 24 AT SINGLE PROPORTIONATE DISTANCE.

C) Was the corner restored through acceptance of (1) an obliterated evidence location, or, (2) a found perpetuated location?

DID NOT ACCEPT LOCATION NOR REJECT IT. THE NW COR OF SEC 30 IS NOT THE CUT LIMESTONE. CORNER NEEDS TO BE EXCAVATED FOR.

D) Describe any material discrepancy between the location of the corner as restored or reestablished and the location of that corner as previously restored or reestablished by distance and direction. Show the discrepancy on the plan view drawing under (a), above. Show the distances between the corner as previously restored or reestablished and (1) the corner as restored or reestablished, and (2) to at least 4 of the witness monuments shown on the drawing in (a), above.

I, Donald Barnes, hereby certify that the corner points as identified by the corner code index were, in a field survey on, established, re-established, monumented, re-monumented, recovered or restored as expressed below and in conformance with the regulations and rules as required in the current manual of survey instructions of the United States Department of Interior, Bureau of Land Management.

COUNTY SURVEYOR FILING DATA

Date of computer entry _____

Date microfilmed _____

Number of included sheets _____
CORNER CODE

seal

OCT 16, 1998

Donald Barnes

EMBOSS LAND SURVEYOR SEAL

A-E 7.08 REQUIREMENT

R-3

U.S. PUBLIC LAND SURVEY MONUMENT RECORD

For Public Land Survey Corners in:

WI ADMINISTRATIVE CODE A-E 7.08 REQUIREMENT

T. 1 N., R. 12 E 4th P.M.

CORNER CODE INDEX

BELOIT TWP TWP

ROCK COUNTY, WI

IF AVAILABLE
ROCK COUNTY COORDINATES PREFERRED

A	1	2	3	4	5	6	7	8	9	10	11	12	13	14	15	16	17	18	19	20	21	22	23	24	25
B	6																								
C																									
D																									
E																									
F																									
G	7	8	9	10	11	12	13	14	15	16	17	18	19	20	21	22	23	24	25	26	27	28	29	30	
H																									
I																									
J																									
K	18	17	16	15	14	13	12	11	10	9	8	7	6	5	4	3	2	1							
L																									
M																									
N																									
O																									
P	19	20	21	22	23	24	25	26	27	28	29	30	31	32	33	34	35	36							
Q																									
R																									
S																									
T																									
U																									
V																									
W																									
X																									
Y																									
Z																									

North _____ Elev. _____

East _____

Hor. Datum _____ Vert. Datum _____


LATITUDE _____ ELLIPS. HT. _____

LONGITUDE _____

ELLIPS. DATUM _____
NAD83(91) _____ COUNTY _____ LIST _____

GPS (X) _____ TRAVERSE (X) _____

BASED ON THE FOLLOWING CONTROL: _____

PLACE MONUMENT SYMBOL  AT PROPER LOCATION ON ABOVE INDEX

 CORNER MONUMENT

WITNESS MONUMENT

(a)

BEARINGS ARE BASED ON: _____

FIELD BOOK _____ PAGE # _____


SHEET 2 OF 2

SHOW A PLAN VIEW DRAWING DEPICTING THE CORNER MONUMENT AND SURROUNDING PHYSICAL FEATURES, INCLUDING THE EXCAVATION AREA AND DEPTH.

PLANNING & ZONING COMMITTEE ADOPTED THE ABOVE FORM ON 12/2/1982

CORNER CODE R-3

Donald Barnes
 OCT 16, 1998

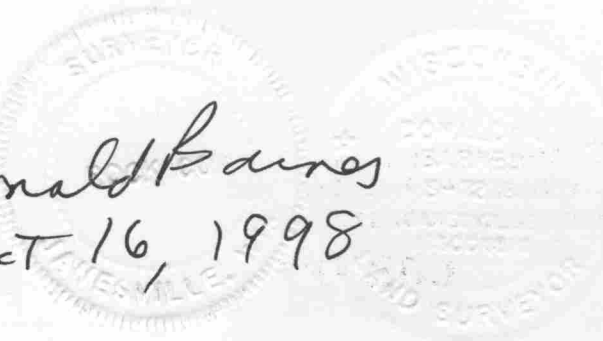

A026
 SE COR
 SEC 24
 L.S. IN
 MON. BOX

FD T-BAR
 PAINTED 700

S88-31-07E 2554.62

N68-12-38E
 16.29

S88-13-48E 2595.25

FD PIN S88-22-23E 2610.19

S88-22-24E 2539.66

S 1/4
 SEC 19

S61-36-33E 5882.38

S44-03-10E 3791.40

S0-35-09E 2650.91

E 1/4 COR
 SEC 30
 COR AS REFERENCED

5.5' SOUTH OF NORTH PVMT EDGE
 148'+/- WEST OF WEST POWER
 LINE OF HIGH VOLTAGE TOWERS.

R-3

SPRING CREEK RD

PADDOCK RD

