## U.S.


## PUBLIC LAND SURVEY MONUMENT RECORD

For Public Land Survey Corners in:

WI ADMINISTRATIVE CODE A-E 7.08 REQUIREMENT

T. \_N., R. \_12\_E

CORNER CODE INDEX

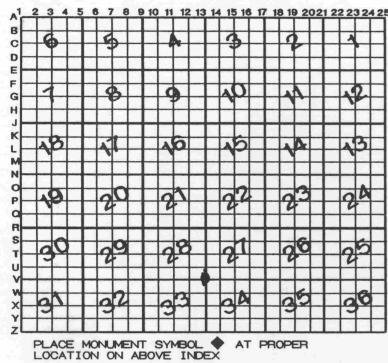

BELOIT TWP ROCK COUNTY WI

IF AVAILABLE ROCK COUNTY COORDINATES PERFERRED

North 206,43/.09 Elev.

East 480,305.26

Hor. Datum COUNTY Vert. Datum

LATITUDE \_\_\_\_\_ELLIPS. HT.

LONGITUTE

GPS (X) \_\_ TRAVERSE (X) \_\_

BASED ON THE FOLLOWING CONTROL:

♦ CORNER MONUMENT

BEARINGS ARE BASED ON:

(a)

FIELD BOOKPAGE # SHEET OF _	_
SHOW A PLAN VIEW DRAWING DEPICTING THE CORNER MONUMENT AND SURROUNDING	
PHYSICAL FEATURES, INCLUDING THE EXCAVATION AREA AND DEPTH.	
PLANNING & ZONING COMMITTEE ADOPTED THE ABOVE FORM ON 12/2/1982	
CORNER CORE U/	2

## BE607

(B) Describe any record evidence, monument evidence, occupational evidence, testimonial evidence or any other material evidence you considered, and whether the monument was found or placed.

1920 BATTERMAN SUB BK 10 PG 17. CALLS FOR IRON ROD, 2612 TO S 1/4 COR SEC 27, 2667.1 TO W 1/4 COR SEC 27, ANGLE OF 90-05 FROM W 1/4 COR SEC 27 TO S 1/4 COR SEC 27, 33 NORTH OF SOUTH ROW OF LIBERTY, 33 SOUTH OF NORTH ROW OF LIBERTY, AND 33 WEST OF EAST ROW OF FREDERICK ST.

1931 SUNNY VOL 3 PG 189 FD IRON ROD MON SET BY BATTERMAN IN 1920.

1969 BATTERMAN VOL 4 PG 461 FD 2" PIPE & REFERENCED SAME

1976 BARNES VOL 5 PG 129 SET PK & REFERENCED SAME.

1979 BARNES VOL 6 PG 3. FD PK AS SET ON 2/26/76 UNDER THAT FD 1 1/2X22 PIPE & UNDER THAT FD 1/4X12" REROD. REPLACED WITH ALUM. MON.

FOUND ALUM. MON.

- C) Was the corner restored through acceptance of (1) an obliterated evidence location, or, (2) a found perpetuated location? ACCEPTED FOUND PERPETUATED LOCATION.
- D) Describe any material discrepancy between the location of the corner as restored or reestablished and the location of that corner as previously restored or reestablished by distance and direction. Show the discrepancy on the plan view drawing under (a), above. Show the distances between the corner as previously restored or reestablished and (1) the corner as restored or reestablished, and (2) to at least 4 of the witness monuments shown on the drawing in (a), above.
- (E) Was the corner reestablished through lost corner proportionate methods? If so, show the method, including the directions and distances to other public land survey corners used as evidence or used for proportioning the corner location.

I, Donald Barnes, hereby certify that the corner points as identified by the corner code index were, in a field survey on, MARCH 1998, established, re-established, monumented, re-monumented, recovered or restored as expressed below and in conformance with the regulations and rules as required in the current manual of survey instructions of the United States Department of Interior, Bureau of Land Management.

Donald Baines March 19, 1998

COUNTY SURVEYOR FILING DATA

Date of computer entry\_

Date microfilmed

Number of included sheets CORNER CODE

EMBOSS LAND SURVEYOR SEAL

A-E 7.08 REQUIREMENT

