U.S.

5


BANED

BEADINGS ARE

SURVEY TUBLIC MONUMENT RECORD

For Public Land Survey Corners in the T. (M., R. 13 E

CORNER CODE INDEX

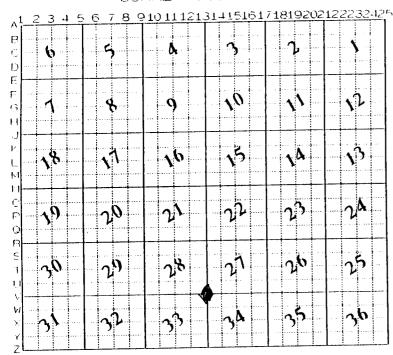

TURTLE		.1.	WI
ROCK	COUNTY	W1	

IF AVAILABLE ROCK COUNTY COORDILIATES PERFERRED

North \$206, 1/2,82 Elev.

East 5/2, 055,29

Hor. Datum _____ Vert. Datum ____

TRAVERSE (X) X GPS (X)

BASED OF THE FOLLOWING CONTROL:

PLACE MONUMENT SYMBOL & LOCATION ON ABOVE INDEX

CORNER MONUMENT

O WITHESS MONUMENT

(a) Fd wait IN 2" pipE

Fd TIES IN JOL & pg 101

FIELD BOOK

PAGE #

SHOW A PLAN VIEW DRAWING DEPICTING THE COTHER MONDERN AND SUPROLUDING PHYSICAL FEATURES, INCLUDING THE EXCAVATION AREA AND DEPTH. THE COPINER MONDERN SHALL HAVE BEFORE OF COMMINION CHARGE OF COLUMN CHARGE OF POTENTIAL PROPERTY OF BROKEFL LEAVE A PERIMEMBETLY MARKETIZED REMAINT AT THE ORIGINAL POINT. IN PROJECT OF THE CAPING CHARGE OF THE ORIGINAL POINT. SHOWEY HORNERS OF THE PROJECT OF THE CAPING WITHOUT CHARGE OF THE COPING WAS AN INVESTIGATION OF THE CAPING OF THE C

FLAFMING & ZOULKO COMMITTEE ADOPTED THE ABOVE FORM ON 12/2/198. WI ADMINISTRATIVE CODE A-E 7.08 REQUIRENEUT

SHEET ____OF ___

- (B) Describe any record evidence, monument evidence, occupational evidence, testimonial evidence or any other material evidence you considered, and whether the monument was found or placed.

 1836 LYONS SET POST CORNER TO SECTIONS 26,27,34,&35. BUR OAK 14 S34W
- 35 & BUR OAK 10 N77W 49.
- 1920 BATTERMAN VOL 3 PG 96 SET GP IN PLACE OF OLD STAKE SURROUNDED BY HARD HEADS.2662.3 TO S 1/4 COR SEC 28.
 1961 BATTERMAN VOL 4 PG 101 FOUND 5/8" PIN & REFERENCED SAME.
- 1968 BATTERMAN VOL 4 PG 376 2649.54 TO W 1/4 COR SEC 27,2620.64 TO S 1/4 COR SEC 27,& ANGLE OF 92-08-44 FROM W 1/4 COR TO S 1/4 COR SEC 27.
- 1979 BARNES VOL 5 PG 539 FOUND 2" PIPE 2657.06 TO E 1/4 COR SEC 33. 1979 BARNES VOL 6 PG 413 REPEAT OF VOL 5 PG 539.

FOUND NAIL IN 2" PIPE & REFERENCE TIES FROM VOL 4 PG 101. 2661.36 (REC 2661.3) TO S 1/4 COR SEC 28, 2620.60 (REC 2620.64) TO S 1/4 COR SEC 27, 2657.31 (REC 2657.06) TO E 1/4 COR SEC 33, & 2651.26 (REC 2649.54) TO W 1/4 COR SEC 27.

- Was the corner restored through acceptance of (1) an obliterated evidence location, or, (2) a found perpetuated location? ACCEPTED FOUND PERPETUATED LOCATION.
- Describe any material discrepancy between the location of the corner as restored or reestablished and the location of that corner as previously restored or reestablished by distance and direction. Show the discrepancy on the plan view drawing under (a), above. Show the distances between the corner as previously restored or reestablished and (1) the corner as restored or reestablished, and (2) to at least 4 of the witness monuments shown on the drawing in (a), above.
- was the corner reestablished through lost corner proportionate methods? If so, show the method, including the directions and distances to other public land survey corners used as evidence or used for proportioning the corner location.

I, Donald Barnes, hereby certify that the corner points as identified by the corner code index were, in a field survey on, 1994, established, re-established, monumented, re-monumented, recovered or restored as expressed below and in conformance with the regulations and rules as required in the current manual of survey instructions of the United States Department of Interior, Bureau of Land Management.

COUNTY SURVEYOR FILING DATA

Date of computer entry

Date microfilmed

Number of included sheets CORNER CODE

EMBOSS LAND SURVEYOR SEAL

A-E 7.08 REQUIREMENT