Faper weight- 32# 25% Rag Ledger (minimum)

Black nonfading inh म्ह्यामा छ।


U.S.

^ ND "UBLIC MONUMENT RECORD

SURVEY

For Public Land Survey Corners in the T. LII, R. 13 E

CORNER CODE INDEX

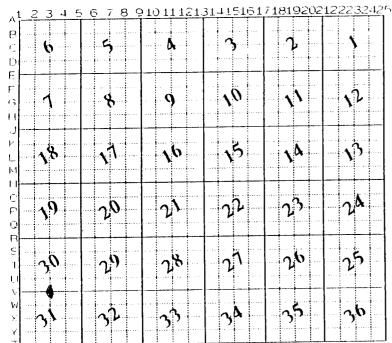

TURTLE ROCK COUNTY WI

IF AVAILABLE ROCK COUNTY COORDITIATES PERFERRED

North 206,298,26 Elev.

East 498, 759,63

Hor. Datum <u>COUNT</u>Y Vert. Datum _____

TRAVERSE (X) X GPS (X) BASED ON THE FOLLOWING CONTROL:

PLACE MONUMENT SYMBOL & LOCATION ON ABOVE INDEX

CORNER MONUMENT

O WITHESS MONUMENT

(a)

BEARINGS ARE BASED ON:

ELAINING & ZOUING COMMITTEE ADOPTED THE ABOVE FORM ON 12/2/1992 WI ADMINISTRATIVE CODE A-E 7.08 REQUIRENEUT

SHEET / OF Z

TU602

- (B) Describe any record evidence, monument evidence, occupational evidence, testimonial evidence or any other material evidence you
- considered, and whether the monument was found or placed.

 1836 ORSON LYON BUR OAK 14 S58E 94, BUR OAK 7 N70E 51. CALLS FOR 2640 TO SE CORNER OF SEC 30 & 2508 TO SW CORNER OF SECTION 30
- 1859 HOBART VOL 1 PG 107 CALLS FOR BL OAK 3 S95W 21,2638.68 TO SE COR SEC 20,N89-58W TO SW COR SEC 20,2593.80 NO-44W TO CENTER SEC 30.
- 1874 RUGER VOL 2 PG 149 FOUND STUMPS OF BT OLD FENCE POST HOLE AT CORNER. DROVE STAKE DEEP & PUT ON TOP OF IT HH 16X10X7 SURROUNDED BY 4 HH STONES. USED TO SUBDIVIDE SEC 31.
- 1885 RUGER VOL 2 PG 295. FOUND CORNER ESTABLISHED BY SELF. SUBDIVIDE SEC 30. CALLS FOR 2646.93' FROM CENTER TO E 1/4;2465.92' FROM CENTER TO W 1/4,2648.80 FROM CENTER TO N 1/4,& 317.41 FROM CENTER TO CENTER OF MILWAUKEE ROAD.
- 1953 SHIMEALL P16 PG 19 "EARLE MORRIS ADDITION" CALLS FOR AN IRON PIN & 2315.66 TO THE CENTER OF MILWAUKEE RD ALONG THE N/S CENTER OF SECTION 31.
- 1959 BATTERMAN MAP #4974
- 1959 BATTERMAN CSM VOL 1 PG 22
- 1961 RICHARDSEN CSM VOL 1 PG 63
- 1964 BATTERMAN CSM VOL 1 PG 101 1972 BATTERMAN LEE CSM VOL 3 PG 117
- 1974 LEE MAP #6375
- STATES NOTHING 1979 BARNES VOL 6 PG 14 TRAVERSE PROVIDED BY BATTERMAN. ABOUT THE CORNER BUT CALLS FOR 2647.05 TO THE NE CORNER & 91-13-47 AT THE NE CORNER FROM THE E 1/4 TO THE N 1/4 CORNERS OF SECTION 31.
- 1982 COMBS CSM VOL 11 PG 102
- 1982 LEE CSM VOL 11 PG 276
- 1987 LEE CSM VOL 13 PG 102
- 1988 COMBS MAP #12359

FOUND 2"X36" GAS PIPE & CARSONITE POST. REPLACED WITH POLY MONUMENT & REPLACED CARSONITE POST 0.2' SOUTH OF MONUMENT. IN HARMONY WITH RECORD DISTANCES. 2514.67 TO SW AND 2646.93 (REC 2647.05) TO SE CORNERS OF SEC 30. ANGLE OF 91-13-40 (REC 91-13-47) AT NE FROM E 1/4 TO N 1/4 CORNERS OF SECTION 31.

- Was the corner restored through acceptance of (1) an obliterated evidence location, or, (2) a found perpetuated location? ACCEPTED FOUND PERPETUATED LOCATION.
- D) Describe any material discrepancy between the location of the corner as restored or reestablished and the location of that corner as previously restored or reestablished by distance and direction. Show the discrepancy on the plan view drawing under (a), above. distances between the corner as previously restored or reestablished and (1) the corner as restored or reestablished, and (2) to at least 4 of the witness monuments shown on the drawing in (a), above I, Donald Barnes, hereby certify that the corner points as identified by the corner code index were, in a field survey on, May 5, 1995, established, re-established, monumented, re-monumented, recovered or restored as expressed below and in conformance with the regulations and rules as required in the current manual of survey instructions of the United States Department of Interior, Bureau of Land Management.

COUNTY SURVEYOR FILING DATA Donald Barnes 6-12-95 Date of computer entry Date microfilmed

Number of included sheets CORNER CODE

EMBOSS LAND SURVEYOR SEAL

V-3