

PUBLIC LAND SURVEY MONUMENT RECORD

For Public Land Survey Corners in the


T. 1N., R. 13E.

CORNER CODE INDEX

	1	2	3	4	5	6	7	8	9	10	11	12	13	14	15	16	17	18	19	20	21	22	23	24	25
A																									
B																									
C																									
D																									
E																									
F																									
G																									
H																									
I																									
J																									
K																									
L																									
M																									
N																									
O																									
P																									
Q																									
R																									
S																									
T																									
U																									
V																									
W																									
X																									
Y																									

PLACE MONUMENT SYMBOL (◆) AT PROPER LOCATION ON ABOVE INDEX

EXAMPLE

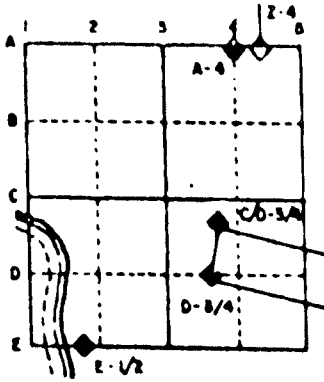

TURTLE TWP  
ROCK COUNTY WI

IF AVAILABLE  
STATE PLANE COORDINATES

North (Y) 203,455.52 Elev. (Z) \_\_\_\_\_  
East (X) 512,060.86 Zone \_\_\_\_\_  
Hor. Datum COUNTY Vert. Datum \_\_\_\_\_

◆ CORNER MONUMENT

○ WITNESS MONUMENT

NE COR  
SEC 33  
FD 2" PIPE

BEARINGS ARE BASED ON: COUNTY SYSTEM

W 1/4 COR  
SEC 33  
FD ALUM

E 1/4 COR  
SEC 33  
FD ALUM.

N0-07-12W 2657.31

S0-07-27E 2656.84

N88-49-30W 5305.98

S88-47-02E 5253.57

FD POLY

E 1/4 COR  
SEC 34

FD ALUM  
SE COR  
SEC 33

SHEET \_\_\_ OF \_\_\_

CORNER CODE: X13

(B) Describe any record evidence, monument evidence, occupational evidence, testimonial evidence or any other material evidence you considered, and whether the monument was found or placed.

1836 LYONS SET QUARTER SECTION POST BUR OAK 7 N30E 7& BUR OAK 15 N67W 36.

1979 BARNES VOL 5 PG 539 FENCES & CORNER WERE DESTROYED. SET ALUM. MON. 15" DEEP ON LINE WITH NE & SE COR 33 AT SINGLE PROPORTIONATE MEASUREMENT. 2657.06 TO NE & SE CORNERS OF SEC 33 AND AN ANGLE OF 88-41-34 AT THE SE COR OF SEC 33 FROM THE NW COR SEC 1 TO THE E 1/4 COR SEC 33.

1991 BARNES VOL 6 PG 413 SAME AS VOL 5 PG 539.

FOUND ALUM MON. 2657.31 (REC 2657.06) TO NE COR SEC 33, 2656.84 (REC 2657.06) TO SE COR SEC 33, AN ANGLE OF 88-41-38 (REC 88-41-34) AT THE SE COR SEC 33 FROM THE NW COR SEC 1 TO THE E 1/4 COR SEC 33, & AN ANGLE OF 179-59-45 (REC 180-00-00) AT THE E 1/4 COR SEC 33 FROM THE NE TO SE CORNERS OF SEC 33.

C) Was the corner restored through acceptance of (1) an obliterated evidence location, or, (2) a found perpetuated location?


ACCEPTED FOUND PERPETUATED LOCATION.

D) Describe any material discrepancy between the location of the corner as restored or reestablished and the location of that corner as previously restored or reestablished by distance and direction. Show the discrepancy on the plan view drawing under (a), above. Show the distances between the corner as previously restored or reestablished and (1) the corner as restored or reestablished, and (2) to at least 4 of the witness monuments shown on the drawing in (a), above.

(E) Was the corner reestablished through lost corner proportionate methods? If so, show the method, including the directions and distances to other public land survey corners used as evidence or used for proportioning the corner location.

NO

I, Donald Barnes, hereby certify that the corner points as identified by the corner code index were, in a field survey on, 1994, established, re-established, monumented, re-monumented, recovered or restored as expressed below and in conformance with the regulations and rules as required in the current manual of survey instructions of the United States Department of Interior, Bureau of Land Management.

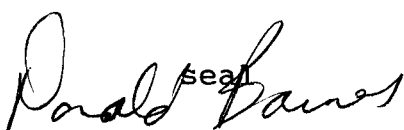  
7/13/95

COUNTY SURVEYOR FILING DATA

Date of computer entry \_\_\_\_\_

Date microfilmed \_\_\_\_\_

Number of included sheets \_\_\_\_\_

CORNER CODE

EMBOSS LAND SURVEYOR SEAL

A-E 7.08 REQUIREMENT

X13