

U.S. PUBLIC LAND SURVEY MONUMENT RECORD

For Public Land Survey Corners in the


T. 1 N., R. 13 E.

CORNER CODE INDEX

	1	2	3	4	5	6	7	8	9	10	11	12	13	14	15	16	17	18	19	20	21	22	23	24	25
A																									
B																									
C																									
D																									
E																									
F																									
G																									
H																									
I																									
J																									
K																									
L																									
M																									
N																									
O																									
P																									
Q																									
R																									
S																									
T																									
U																									
V																									
W																									
X																									
Y																									
Z																									

PLACE MONUMENT SYMBOL (◈) AT PROPER LOCATION ON ABOVE INDEX

EXAMPLE

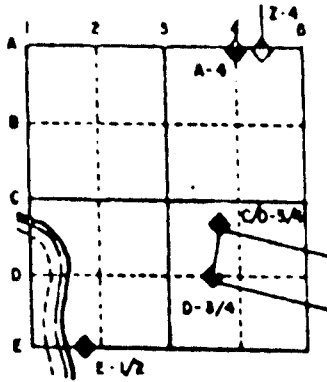

TURTLE TWP
ROCK COUNTY WI

IF AVAILABLE
STATE PLANE COORDINATES

North (Y) 230,027.26 Eleve. (Z) _____

East (X) 512,048.96 Zone _____

Hor. Datum COUNTY Vert. Datum _____

◈ CORNER MONUMENT

○ WITNESS MONUMENT

BEARINGS ARE BASED ON:

(B) Describe any record evidence, monument evidence, occupational evidence, testimonial evidence or any other material evidence you considered, and whether the monument was found or placed.

- 1836 ORSON LYON SET QUARTER SECTION POST BUR OAK 10 S3?W 116.9 & BUR OAK 10 S2E 113.9. CALLS FOR 2640 TO SW COR SEC 3 AND 2891.46 TO NW COR SEC 3.
- 1861 RUGER VOL 1 PG 152 STATES NOTHING ABOUT CORNER. USED TO SUBDIVIDED SECTION 3. CENTER AT EQUAL DISTANCE BETWEEN E & W 1/4 CORNERS. 2680.92 TO CENTER OF SECTION 3.
- 1891 BLEEDORN VOL 2 PG 458 FD HH AT CORNER.
- 18?? RUGER VOL 2 PG 522 HH 12X7.5X7.5. 2653.86 TO SE COR SEC 4.
- 1940 BATTERMAN MAP #4592
- 1940 BATTERMAN P3 PG 5 & P12 PG 27
- 1964 BATTERMAN VOL 4 PG 203. FD LARGE HH REPLACED GUN BARREL AT CENTER SEC 4 WITH ALUM. MON.
- 1973 LEE MAP #4627
- 1973 LEE CSM VOL 3 PG 283
- 1974 LEE MAP #4605
- 1980 COMBS CSM 11 PG 104
- 1994 KREBS MAP #11574

FOUND C.I. MON. PLACED CARSONITE POST.

C) Was the corner restored through acceptance of (1) an obliterated evidence location, or, (2) a found perpetuated location?
ACCEPTED FOUND MONUMENT.

D) Describe any material discrepancy between the location of the corner as restored or reestablished and the location of that corner as previously restored or reestablished by distance and direction. Show the discrepancy on the plan view drawing under (a), above. Show the distances between the corner as previously restored or reestablished and (1) the corner as restored or reestablished, and (2) to at least 4 of the witness monuments shown on the drawing in (a), above.

(E) Was the corner reestablished through lost corner proportionate methods? If so, show the method, including the directions and distances to other public land survey corners used as evidence or used for proportioning the corner location.
NO

I, Donald Barnes, hereby certify that the corner points as identified by the corner code index were, in a field survey on, _____, 199____, established, re-established, monumented, re-monumented, recovered or restored as expressed below and in conformance with the regulations and rules as required in the current manual of survey instructions of the United States Department of Interior, Bureau of Land Management.

seal

Donald Barnes
6/12/95

EMBOSS LAND SURVEYOR SEAL

COUNTY SURVEYOR FILING DATA

Date of computer entry _____

Date microfilmed _____

Number of included sheets 1
CORNER CODE

