

PUBLIC LAND SURVEY MONUMENT RECORD


For Public Land Survey Corners in the
T. 2 N., R. 13 E.

CORNER CODE INDEX

	1	2	3	4	5	6	7	8	9	10	11	12	13	14	15	16	17	18	19	20	21	22	23	24	25
A																									
B																									
C																									
D																									
E																									
F																									
G																									
H																									
I																									
J																									
K																									
L																									
M																									
N																									
O																									
P																									
Q																									
R																									
S																									
T																									
U																									
V																									
W																									
X																									
Y																									
Z																									

PLACE MONUMENT SYMBOL (◆) AT PROPER LOCATION ON ABOVE INDEX

EXAMPLE

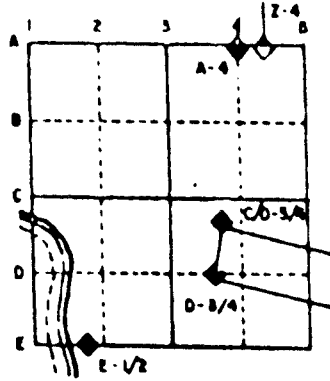

TURTLE TWP
ROCK COUNTY WI

IF AVAILABLE
STATE PLANE COORDINATES

North (Y) _____ Eleve. (Z) _____
East (X) _____ Zone _____
Hor. Datum _____ Vert. Datum _____

◆ CORNER MONUMENT

○ WITNESS MONUMENT

BEARINGS ARE BASED ON :

(B) Describe any record evidence, monument evidence, occupational evidence, testimonial evidence or any other material evidence you considered, and whether the monument was found or placed.
1865 LOCKE VOL 1 PG 235 FOUND POST.

1994 R. COMBS FOUND 2" PIPE.

USED COMBS MEASURED DISTANCES TO COMPUTE THE LOCATION OF THE PIPE FOR THE SECTION MAP.

C) Was the corner restored through acceptance of (1) an obliterated evidence location, or, (2) a found perpetuated location?

SINCE I DID NOT USE THE CORNER BUT MERELY SHOWED THE POSITION, I DID NOT ACCEPT NOR REJECT THE FOUND PIPE.

D) Describe any material discrepancy between the location of the corner as restored or reestablished and the location of that corner as previously restored or reestablished by distance and direction. Show the discrepancy on the plan view drawing under (a), above. Show the distances between the corner as previously restored or reestablished and (1) the corner as restored or reestablished, and (2) to at least 4 of the witness monuments shown on the drawing in (a), above.

(E) Was the corner reestablished through lost corner proportionate methods? If so, show the method, including the directions and distances to other public land survey corners used as evidence or used for proportioning the corner location.

NO

I, Donald Barnes, hereby certify that the corner points as identified by the corner code index were, in a field survey on, _____, 1994, established, re-established, monumented, re-monumented, recovered or restored as expressed below and in conformance with the regulations and rules as required in the current manual of survey instructions of the United States Department of Interior, Bureau of Land Management.

Donald Barnes
July 6, 1994

COUNTY SURVEYOR FILING DATA

Date of computer entry _____

Date microfilmed _____

Number of included sheets 1
CORNER CODE

AFFIX YOUR LAND SURVEYOR SEAL

C3

Donald Barnes
July 6, 1994

BEARINGS & DISTANCES ARE BASED ON
DATA COMPILED FROM TURTLE TWP PROJECT.


LOCKE 1865 2432.10
R. COMBS 1994 2427.16
S89-38-25E 2427.40

LOCKE 1865 2640.00
S89-17-41E 2636.32

BATTERMAN 1964 2639.19
S89-09-20E 2639.65

NW COR

NE COR

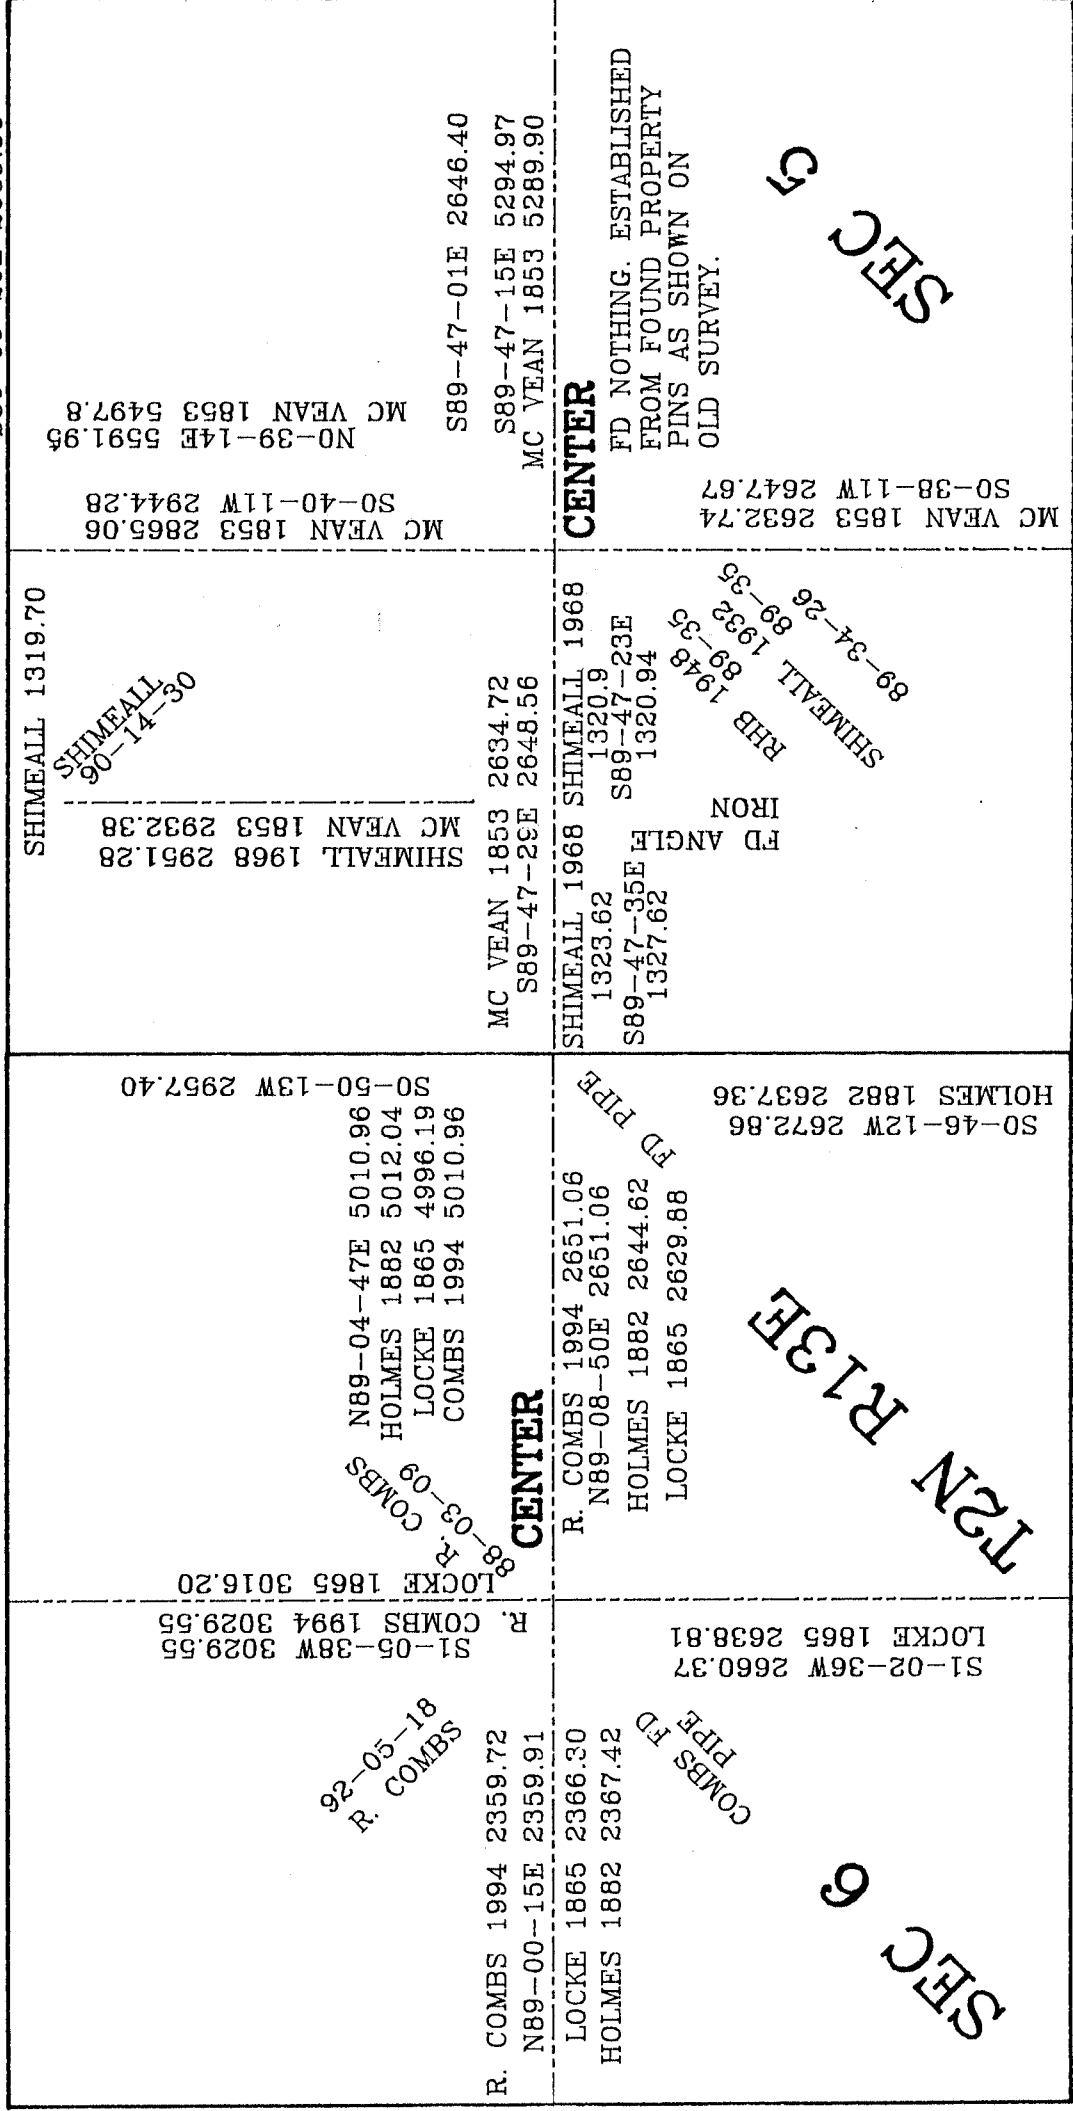

LOCKE 1865 3087.48
S0-11-06E 3085.27
R. COMBS 1994 3085.35

W 1/4 COR

COMBS 1991 2645.90
S0-36-22W 2642.90
LOCKE 1865 2634.26

SW COR

LOCKE 1865 3016.20
R. COMBS 1994 3029.55
S1-05-38W 3029.55
R. COMBS 1994 2359.72
N89-00-15E 2359.91
LOCKE 1865 2366.30
HOLMES 1882 2367.42
COMBS FD
COMBS PIPE

CENTER

R. COMBS 1994 2651.06
N89-08-50E 2651.06
HOLMES 1882 2644.62
LOCKE 1865 2629.88
FD PIPE

T2N R13E

SHIMEALL 1319.70

SHIMEALL 90-14-30

SHIMEALL 1968 2951.28
MC VEAN 1853 2932.38

MC VEAN 1853 2634.72
S89-47-23E 2648.56

SHIMEALL 1968 SHIMEALL 1968
1320.9
S89-47-23E
1320.94
S89-47-35E
1327.62
FD ANGLE
IRON
RHB 1948
89-35
SHIMEALL 1932
89-35
89-34-26

SEC 6

MC VEAN 1853 2865.06
S0-40-11W 2944.28

NO-39-14E 5591.95
MC VEAN 1853 5497.8

S89-47-01E 2646.40

S89-47-15E 5294.97
MC VEAN 1853 5289.90

CENTER

FD NOTHING. ESTABLISHED
FROM FOUND PROPERTY
PINS AS SHOWN ON
OLD SURVEY.

MC VEAN 1853 2632.74
S0-38-11W 2647.67

SEC 5

S0-32-33W 2915.29

E 1/4 CO

LYON 1836 2640.
BATTERMAN 1964 2647.68
S0-26-32W 2654.53

BATTERMAN 1964 2654.00
MC VEAN 1853 2645.94
LYON 1836 2646.93
S89-38-05E 2655.35

N89-39-59E 2655.11
COMBS 1989 2655.08
BATTERMAN 1964 2654.00
LYON 1836 2646.93

N89-25-26E 2663.42
HOLMES 1882 2658.15
LOCKE 1865 2657.16

S 1/4 COR

N89-24-59E 2339.18
LOCKE 1865 2336.90

SE COR