



(B) Describe any record evidence, monument evidence, occupational evidence, testimonial evidence or any other material evidence you considered, and whether the monument was found or placed.

- 1878 RUGER VOL 2 PG 239 FOUND STAKE, ALSO STUMPS OF B.T.s.
- 1882 RUGER FOUND STAKE SURROUNDED NY THREE LIMESTONES. ONE OF THEM BURNT, ALSO FOUND STUMP OF N.W. B.T. SHOWS 2630.1 TO W 1/4 CORNER OF SECTION 25.
- 1929 BATTERMAN VOL 3 PG 173 FOUND LIMESTONE AT CORNER.
- 1930 BATTERMAN VOL 3 PG 173 FOUND LIMESTONE.
- 1939 SUNNY VOL 3 PG 428 FOUND STONE.
- 1942 BATTERMAN BK 12 PG 35. NEWFIELD'S ADDITION. CALLS FOR A STONE MONUMENT AT THE CORNER. PLAT SHOWS DISTANCES AND BEARINGS TO STONE.

ESTABLISHED CORNER FROM MONUMENTS THAT I FOUND IN NEWFIELD'S ADDITION.


C) Was the corner restored through acceptance of (1) an obliterated evidence location, or, (2) a found perpetuated location?

RESTORED THROUGH ACCEPTANCE OF OBLITERATED EVIDENCE LOCATION.

D) Describe any material discrepancy between the location of the corner as restored or reestablished and the location of that corner as previously restored or reestablished by distance and direction. Show the discrepancy on the plan view drawing under (a), above. Show the distances between the corner as previously restored or reestablished and (1) the corner as restored or reestablished, and (2) to at least 4 of the witness monuments shown on the drawing in (a), above.

(E) Was the corner reestablished through lost corner proportionate methods? If so, show the method, including the directions and distances to other public land survey corners used as evidence or used for proportioning the corner location.

I, Donald Barnes, hereby certify that the corner points as identified by the corner code index were, in a field survey on, SEPTEMBER 13 1989, established, re-established, monumented, re-monumented, recovered or restored as expressed below and in conformance with the regulations and rules as required in the current manual of survey instructions of the United States Department of Interior, Bureau of Land Management.

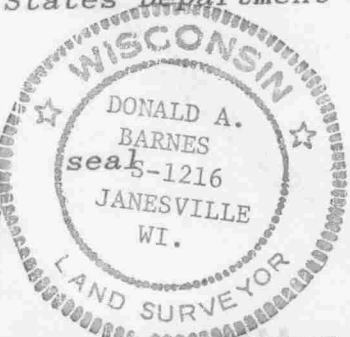

AFFIX YOUR LAND SURVEYOR SEAL

COUNTY SURVEYOR FILING DATA

Date of computer entry \_\_\_\_\_

Date microfilmed \_\_\_\_\_

Number of included sheets R21  
CORNER CODE