


# U.S. PUBLIC LAND SURVEY MONUMENT RECORD

For Public Land Survey Corners in the  
T. 1 N., R. 12 E.  
CORNER CODE INDEX

	1	2	3	4	5	6	7	8	9	10	11	12	13	14	15	16	17	18	19	20	21	22	23	24	25
A																									
B	6																								
C		5																							
D			4																						
E				3																					
F					2																				
G																									
H	7																								
J		8																							
K			9																						
L				10																					
M					11																				
N						12																			
O							13																		
P	18																								
Q		17																							
R			16																						
S				15																					
T					14																				
U						15																			
V							16																		
W								17																	
X									18																
Y										19															
Z											20														
												21													
													22												
														23											
PLACE MONUMENT SYMBOL (◆) AT PROPER LOCATION ON ABOVE INDEX

### EXAMPLE

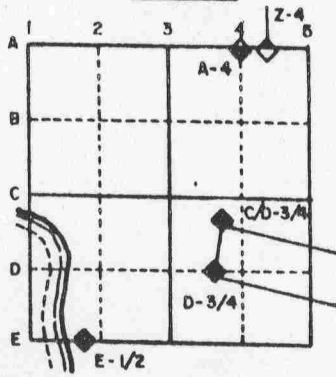

BELOIT TWP  
ROCK COUNTY WI

IF AVAILABLE  
STATE PLANE COORDINATES

North (Y) 187,617.30      Eleve. (Z) \_\_\_\_\_  
East (X) 2,261,136.25      Zone \_\_\_\_\_  
Hor. Datum \_\_\_\_\_      Vert. Datum \_\_\_\_\_

(a)      ◆ CORNER MONUMENT

○ WITNESS MONUMENT

BEARINGS ARE BASED ON: 1927 STATE PLANE

MICROFILMED

FIELD BOOK 1 PAGE # 57-77

SHOW A PLAN VIEW DRAWING DEPICTING THE CORNER MONUMENT AND SURROUNDING PHYSICAL FEATURES, INCLUDING THE EXCAVATION AREA AND DEPTH. THE CORNER MONUMENT SHALL HAVE THE FOLLOWING CHARACTERISTICS: 1) HAVE AT LEAST TWO PREDETERMINED BREAK-OFF POINTS. 2) IF BROKEN, LEAVE A PERMANENTLY MAGNETIZED REMNANT AT THE ORIGINAL POINT. 3) MUST BE EXTENDABLE. 4) THE CAP IS INSCRIBED: ROCK COUNTY SURVEY MONUMENT - PENALTY FOR DISTURBING MARKER. 5) OR AN EXISTING CUT LIMESTONE. AN IRON PIPE 1 1/2" x 4'0" (MINIMUM) MAY BE USED IN AREAS WHERE GROUND WATER IS WITHIN ONE FOOT OF THE SURFACE. IF THE CORNER IS OCCUPIED BY AN IMPROVEMENT (MANHOLE, BURIED CABLE, ETC.) ANY DURABLE, DISTINCT MONUMENT MAY BE USED. CORNERS SHALL BE REFERENCED WITH AT LEAST 4 DURABLE WITNESS MONUMENTS. WITNESS MONUMENTS SHALL BE MADE OF CONCRETE, NATURAL STONE, IRON OR OTHER EQUALLY DURABLE MATERIAL, EXCEPT WOOD. DESCRIBE THE CORNER AND THE WITNESS MONUMENTS.

CORNER CODE:

V 21

(B) Describe any record evidence, monument evidence, occupational evidence, testimonial evidence or any other material evidence you considered, and whether the monument was found or placed.

1836 ORSON LYON. ORIGINAL GOVERNMENT NOTES.

1886 RUGER'S SUBDIVISION "WHEELER'S ADDITION TO BELOIT "BOOK 4 PAGE 37B SHOWS THE SW CORNER OF SECTION 25 AND STATES THAT THE SOUTH 1/16TH CORNER OF THAT SW 1/4 IS A TRIANGULAR POINTED LIMESTONE 15X14X12. HE DOES NOT STATE THE DISTANCE TO THE SECTION CORNERS. HE SHOWS THE SECTION LINE AND NORTH/SOUTH DISTANCES TO VARIOUS POINTS ON THE MAP.

1891 HOLMES'S "PEET AND SALMON'S" SUBDIVISION BOOK 5 PG 15. STATES THAT THE POINT OF BEGINNING IS S1-15W 340.56 FROM THE SECTION CORNER. THE BEARING AND DISTANCE TO A COMPUTED POSITION IS S1-40-00W 339.35. HE ALSO STATES THE DISTANCE AND BEARING FROM A LOT CORNER ON THE SOUTH SIDE OF LAWTON FROM A STONE MONUMENT AT THE INTERSECTION OF LAWTON AVENUE AND THE NORTH LINE OF SECTION 36 IS S52-23W 196.35. THE DISTANCE FROM A FOUND PIPE TO THIS COMPUTED POSITION IS S56-55-38W 197.48.


1942 BATTERMAN. PLAT OF SURVEY OF THE FAIRBANKS MORSE COMPANY. HIS MAP WHICH WAS FILED IN THE BELOIT CITY ENGINEER'S OFFICE SHOWS THE SOUTH LINE OF THE SW 1/4 OF SECTION 25. HE SHOWS NORTH/SOUTH DISTANCES FROM THE SECTION LINE TO VARIOUS MONUMENTS. HIS MAP CALLS FOR A DISTANCE OF 2641.82 FROM THE EAST QUARTER CORNER TO THE SOUTHWEST CORNER OF SECTION 26. HE ALSO CALLS FOR AN ANGLE OF 90-12-30 AT THE SOUTHWEST CORNER OF THE SECTION. I COMPUTED AN ANGLE OF 90-14-39. HIS MAP ALSO SHOWS THAT THE CORNER IS IN A BUILDING. THE COMPUTED DISTANCE FROM THE WEST QUARTER CORNER TO THE NW CORNER OF SECTION 25 IS 2631.29. BATTERMAN CALLS FOR A DISTANCE OF 2631.85. THE ANGLE NW CORNER-W 1/4 CORNER-SW CORNER OF SECTION 25 IS 179-59-54. THIS ANGLE IS TO THE RIGHT.

I COULD NOT FIND ANY OTHER SUBDIVISION PLATS, PLAT OF SURVEYS, OR COUNTY SURVEYOR MAPS THAT CONTAINED THE SOUTH WEST CORNER OF SECTION 25. I PLACED THE CORNER IN THE POSITION THAT WAS MOST IN HARMONY WITH BATTERMAN'S SURVEY WHICH IS ALSO IN HARMONY WITH HOLMES AND RUGER'S SURVEYS. THESE VARIOUS CALL DISTANCES ARE SHOW ON THE ENCLOSED MAP. I DID NOT PLACE A MONUMENT BECAUSE THE CORNER IS INSIDE THE BUILDING.

C) Was the corner restored through acceptance of (1) an obliterated evidence location, or, (2) a found perpetuated location?

ACCEPTED OBLITERATED EVIDENCE LOCATION.

I, Donald Barnes, hereby certify that the corner points as identified by the corner code index were, in a field survey on, SEPTEMBER 13, 1989, established, re-established, monumented, re-monumented, recovered or restored as expressed below and in conformance with the regulations and rules as required in the current manual of survey instructions of the United States Department of Interior, Bureau of Land Management.

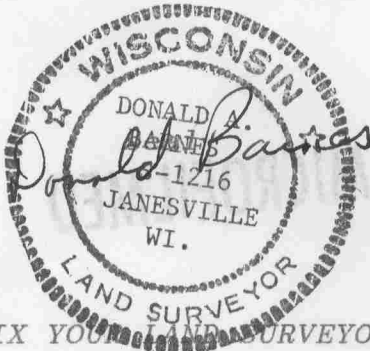

AFFIX YOUR SURVEYOR SEAL

COUNTY SURVEYOR FILING DATA

Date of computer entry \_\_\_\_\_

Date microfilmed \_\_\_\_\_

Number of included sheets 1 / ~~2~~  
CORNER CODE

V21

