
## U.S. PUBLIC LAND SURVEY MONUMENT RECORD

For Public Land Survey Corners in the T. \_/ N. , R. / Z E

CORNER CODE INDEX

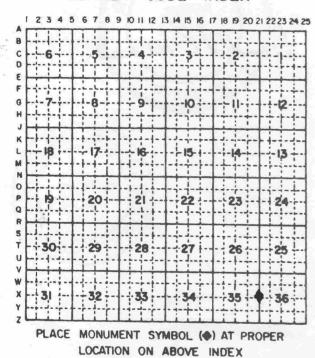

EXAMPLE BELOIT TWP ROCK COUNTY WI

> IF AVAILABLE STATE PLANE COORDINATES

North (Y) Eleve. (Z) East (X) Zone Hor. Datum Vert. Datum

(a.)

CORNER MONUMENT

O WITNESS MONUMENT



## MICROFILMED

FIELD BOOK 2 PAGE # 7,8

SHOW A PLAN VIEW DRAWING DEPICTING THE CORNER MONUMENT AND SURROUNDING PHYSICAL FEATURES, INCLUDING THE EXCAVATION AREA AND DEPTH. THE CORNER MONUMENT SHALL HAVE THE FOLLOWING CHARACTERISTICS: I) HAVE AT LEAST TWO PREDETERMINED BREAK-OFF 2) IF BROKEN, LEAVE A PERMANENTLY MAGNETIZED REMNANT AT THE ORIGINAL POINT. 3) MUST BE EXTENDABLE. 4) THE CAP IS INSCRIBED : ROCK COUNTY SURVEY MONUMENT - PENALTY FOR DISTURBING MARKER. 5) OR AN EXISTING CUT LIMESTONE. AN IRON PIPE 1 2 1 4'0" (MINIMUM) MAY BE USED IN AREAS WHERE GROUND WATER IS WITHIN ONE FOOT OF THE SURFACE. IF THE CORNER IS OCCUPIED BY AN IMPROVEMENT (MANHOLE, BURIED CABLE, ETC.) ANY DURABLE, DISTINCT MONUMENT MAY BE USED. CORNERS SHALL BE REFERENCED WITH AT LEAST 4 DURABLE WITNESS MONUMENTS. WITNESS MONUMENTS SHALL BE MADE OF CONCRETE, NATURAL STONE, IRON OR OTHER EQUALLY DURABLE MATERIAL, EXCEPT WOOD. DESCRIBE THE CORNER AND THE WITNESS MONUMENTS.

CORNER CODE:

cribe any record evi ponument evidence, occ evidence, testimonial evidence or any other material evidence you considered, and whether the monument was found or placed. 1836 LYON SET QUARTER SECTION POST. BEARING TREES: WHITE OAK 32 S25E 21.12', BUR OAK 9 N50 1/2E 14.52' 1840 HOPKINS BK 1 PG 1B. NORTH ONE AND 3/4 DEGREES EAST TO THE QUARTER STAKE BETWEEN SECTIONS, ON THIS COURSE IT IS EIGHT CHAINS, ONE LINK (528.66), TO THE SOUTH SIDE OF RACE STREET. 1882 RUGER VOL 2 PG 406 FOUND STONE MONUMENT & NE BT AND WHERE STUMPS OF SE BT HAD DECAYED TOOK NEW BTS:HICKORY 5 S39E 32, BR OAK 7 S46W 18 1/2, HICKORY 6 S64 1/2W 49. 2630.1 TO THE NW CORNER OF SECTION 36. 19?? R.H. BATTERMAN FIELD BOOK. CALLS FOR THE W 1/4 CORNER OF SECTION 36 AND SHOWS TIES TO THE WINDOW CORNERS AS SHOW IN DIAGRAM. 1965 LEE CSM VOL 1 PG 112 & 119 SHOWS COURSE AND DISTANCE TO CORNER. FOUND PIECE OF WOOD HUB. USED TIES TO PLACE POLY MONUMENT.

- C) Was the corner restored through acceptance of (1) an obliterated evidence location, or, (2) a found perpetuated location?
  ACCEPTED FOUND PERPETUATED LOCATION.
- D) Describe any material discrepancy between the location of the corner as restored or reestablished and the location of that corner as previously restored or reestablished by distance and direction. Show the discrepancy on the plan view drawing under (a), above. Show the distances between the corner as previously restored or reestablished and (1) the corner as restored or reestablished, and (2) to at least 4 of the witness monuments shown on the drawing in (a), above.
- (E) Was the corner reestablished through lost corner proportionate methods? If so, show the method, including the directions and distances to other public land survey corners used as evidence or used for proportioning the corner location.

I, Donald Barnes, hereby certify that the corner points as identified by the corner code index were, in a field survey on, JULY 6,1992, established, re-established, monumented, remonumented, recovered or restored as expressed below and in conformance with the regulations and rules as required in the current manual of survey instructions of the United States Department of Interior, Bureau of Land Management.

Ponald Barney

COUNTY SURVEYOR FILING DATA

Date of computer entry

Date microfilmed

Number of included sheets X-Z

CORNER CODE

AFFIX YOUR LAND SURVEYOR SEAL

Sheet 1 OF 2

DONALD A.
BARNES

PARTICIPATION

SURVE 1986

AND SURVE 1986


A

♦ W 1/4 COR SEC 25

N0-11-18E 2641,25 RUGER 1882 2630,1

NW COR SEC 36

NO-27-36E 2631.76

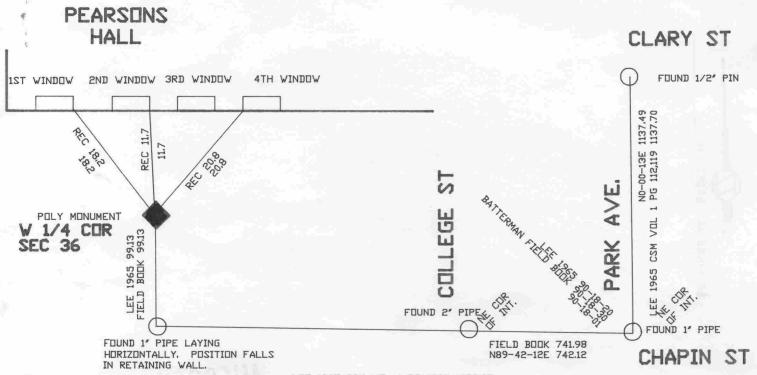

LEE 1965 CSM VOL 1 PG 1965 1379.35

2A COB SEC 39

SHEET ZOF Z