

U.S. PUBLIC LAND SURVEY MONUMENT RECORD

For Public Land Survey Corners in the


T. 1 N., R. 13 E.

CORNER CODE INDEX

	1	2	3	4	5	6	7	8	9	10	11	12	13	14	15	16	17	18	19	20	21	22	23	24	25
A																									
B																									
C																									
D																									
E																									
F																									
G																									
H																									
I																									
J																									
K																									
L																									
M																									
N																									
O																									
P																									
Q																									
R																									
S																									
T																									
U																									
V																									
W																									
X																									
Y																									
Z																									

PLACE MONUMENT SYMBOL (●) AT PROPER LOCATION ON ABOVE INDEX

EXAMPLE

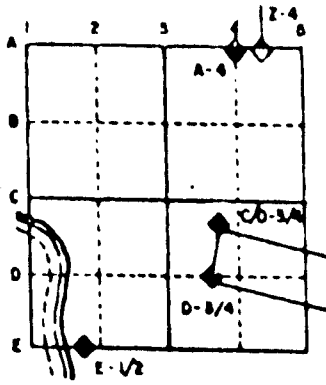

TURTLE TWP
ROCK COUNTY WI

IF AVAILABLE
STATE PLANE COORDINATES

North (Y) _____ Eleve. (Z) _____
 East (X) _____ Zone _____
 Hor. Datum _____ Vert. Datum _____

CORNER MONUMENT
 WITNESS MONUMENT
 Fd ALUM

BEARINGS ARE BASED ON COUNTY SYSTEM

FD 1" PIPE NE COR
SEC 35

W 1/4 COR
SEC 35

E 1/4 COR
SEC 35

E 1/4 COR
SEC 36

FD POLY N88-18-37E 5315.95

S88-05-11E 5301.65

FD ALUM

FD ALUM

SE COR
SEC 35
FD ALUM

NO-08-58W 2653.40
SO-10-45E 2652.08

SHEET 1 OF 1

CORNER CODE: 421

TU619 W 1/4 36

(B) Describe any record evidence, monument evidence, occupational evidence, testimonial evidence or any other material evidence you considered, and whether the monument was found or placed.

1861 HOBART VOL 1 PG 157 NO STATEMENT ABOUT MONUMENT. USED TO SUBDIVIDE SECTION 36. CALLS FOR FROM CENTER OF SECTION 36 TO THE FOLLOWING CORNERS: 2646.6 (?2649.32) W 1/4, 2656.50 (2651.69?) E 1/4 COR, 2656.50 (?2646.28) N 1/4 COR, & 2636.04 (2635.44) TO S 1/4 COR. 2646.6 (TWP PROJ 2646.98) FROM S 1/4 TO SE CORNERS OF SECTION 36

1979 BARNES VOL 55 PG 533 SET ALUM. MON ON LINE WITH NW & SW OF SECTION 36 AT SINGLE PROPORTIONATE DISTANCE. SHROEDER 2647.73 (? TWP 2649.32) TO CENTER 36, 2651.54 (TWP 2651.69) CENTER TO E 1/4, 2646.26 (TWP 2646.28) CENTER TO N 1/4, 2635.24 (TWP 2635.44) TO S 1/4 COR, ANGLE 88-02-35 AT CENTER FROM W 1/4 TO N 1/4 CORNERS, ANGLE 91-57-25 AT CENTER FROM N 1/4 TO E 1/4, ANGLE 92-03-48 AT S 1/4 FROM CENTER TO SE CORNERS OF SECTION 36, ANGLE 91-39-20 AT SW FROM W 1/4 TO S 1/4 CORNERS OF SECTION 36, ANGLE 87-57-03 (TWP? 87-54-52) AT W 1/4 FROM CENTER TO SW, & ANGLE 92-02-57(?TWP 92-05-07) AT W 1/4 FROM NW TO CENTER OF SECTION 36. STATES MONUMENT IS 3' NORTH OF E/W FENCE.

FOUND ALUMINUM MONUMENT.

C) Was the corner restored through acceptance of (1) an obliterated evidence location, or, (2) a found perpetuated location?

ACCEPTED FOUND PERPETUATED LOCATION.

D) Describe any material discrepancy between the location of the corner as restored or reestablished and the location of that corner as previously restored or reestablished by distance and direction. Show the discrepancy on the plan view drawing under (a), above. Show the distances between the corner as previously restored or reestablished and (1) the corner as restored or reestablished, and (2) to at least 4 of the witness monuments shown on the drawing in (a), above.

(E) Was the corner reestablished through lost corner proportionate methods? If so, show the method, including the directions and distances to other public land survey corners used as evidence or used for proportioning the corner location.

NO

I, Donald Barnes, hereby certify that the corner points as identified by the corner code index were, in a field survey on, 1994, established, re-established, monumented, re-monumented, recovered or restored as expressed below and in conformance with the regulations and rules as required in the current manual of survey instructions of the United States Department of Interior, Bureau of Land Management.

COUNTY SURVEYOR FILING DATA

Donald Barnes
seal

Date of computer entry _____

Date microfilmed _____

Number of included sheets _____

CORNER CODE

AFFIX YOUR LAND SURVEYOR SEAL