


U.S. PUBLIC LAND SURVEY MONUMENT RECORD

For Public Land Survey Corners in the
 T. 1 N., R. 13 E.
CORNER CODE INDEX

	1	2	3	4	5	6	7	8	9	10	11	12	13	14	15	16	17	18	19	20	21	22	23	24	25
A																									
B																									
C	6																								
D		5																							
E			4																						
F				3																					
G					2																				
H																									
I																									
J	7																								
K		8																							
L			9																						
M				10																					
N					11																				
O						12																			
P							13																		
Q								14																	
R									15																
S										16															
T											17														
U												18													
V													19												
W														20											
X															21										
Y																22									
Z																	23								
																		24							
																			25						
																				26					
																					27				
																						28			
																							29		
																								30	
																									31
																									32
																									33
																									34
																									35
																									36

PLACE MONUMENT SYMBOL (◆) AT PROPER LOCATION ON ABOVE INDEX

EXAMPLE

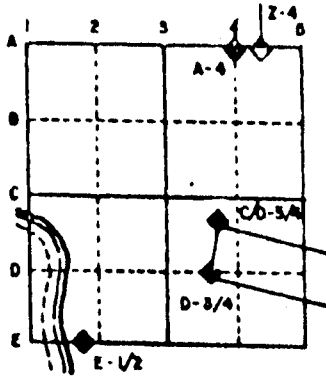


TURTLE TWP
ROCK COUNTY WI

IF AVAILABLE
 STATE PLANE COORDINATES

North (Y) 200,535.22 Elev. (2) _____
 East (X) 522,635.18 Zone _____
 Hor. Datum COUNTY Vert. Datum _____

◆ CORNER MONUMENT

○ WITNESS MONUMENT

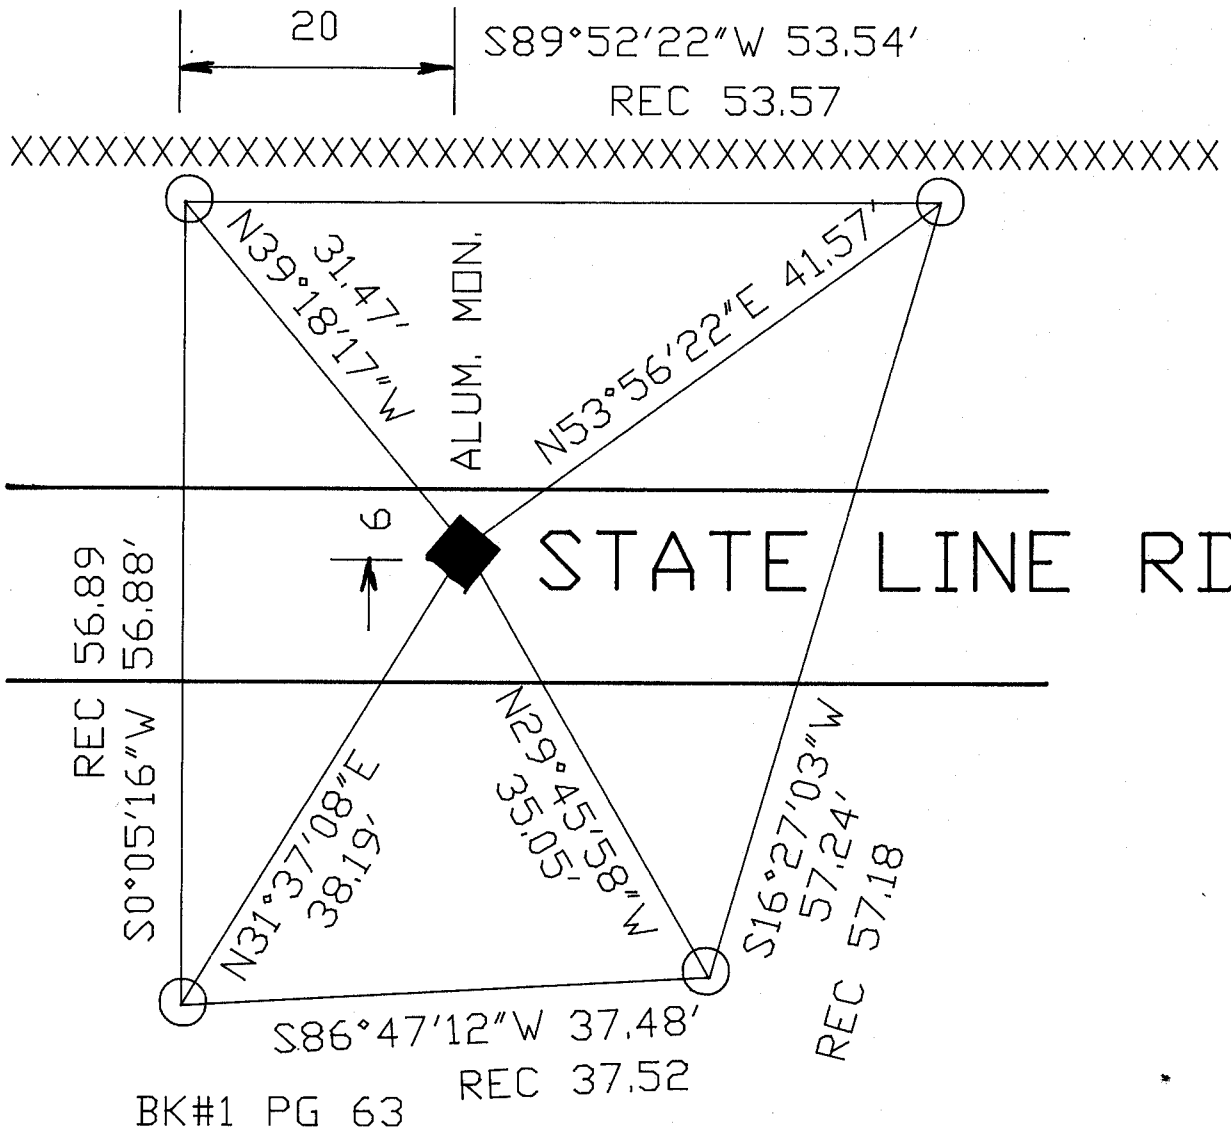

BEARINGS ARE BASED ON ASSUMED

BK#1 PG 63

MICROFILMED

SHEET ___ OF ___

CORNER CODE: 221

(B) Describe any record evidence, monument evidence, occupational evidence, testimonial evidence or any other material evidence you considered, and whether the monument was found or placed.

1833 LYONS ORIGINAL SURVEYOR SET A POST FOR CORNER TO SECTION 35 & 36. BUR OAK 12 N49W 97.02;BLACK OAK 16 N35W 80.52.

1848 WHEELER VOL 6 PG 407 TERRITORIAL ROAD RECORDS. CALLS FOR THE ROAD TO BE 33 FEET NORTH OF THE STATE LINE.

1978 BARNES VOL 5 PG 462 PLACED ALUMINUM MONUMENT ON LINE WITH THE S 1/4 CORNER OF SECTION 36 AND THE NE CORNER OF SECTION 1 T46N R2E AT SINGLE PROPORTIONATE MEASUREMENT. DUG & FOUND OLD ROAD 4' DEEP.

1978 BARNES VOL 5 PG 456 CALLS FOR 2642.90 TO S 1/4 CORNERS OF SECTION 35 AND 26.

FOUND ALUMINUM MONUMENT. REMOVED TOP PART AND INSTALLED ALUMINUM MONUMENT AT INTENDED LOCATION.

C) Was the corner restored through acceptance of (1) an obliterated evidence location, or, (2) a found perpetuated location?



NO

D) Describe any material discrepancy between the location of the corner as restored or reestablished and the location of that corner as previously restored or reestablished by distance and direction. Show the discrepancy on the plan view drawing under (a), above. Show the distances between the corner as previously restored or reestablished and (1) the corner as restored or reestablished, and (2) to at least 4 of the witness monuments shown on the drawing in (a), above.

THERE WAS A BLUNDER IN THE PLACEMENT OF THE MONUMENT. THERE WERE NO SURVEYS OF RECORD THAT USED THAT MONUMENT. REMOVED TOP PORTION OF THE MONUMENT AND PLACED A POLY MONUMENT AT THE 1978 INTENDED LOCATION.

(E) Was the corner reestablished through lost corner proportionate methods? If so, show the method, including the directions and distances to other public land survey corners used as evidence or used for proportioning the corner location.

I, Donald Barnes, hereby certify that the corner points as identified by the corner code index were, in a field survey on, November 20,1991, established, re-established, monumented, re-monumented, recovered or restored as expressed below and in conformance with the regulations and rules as required in the current manual of survey instructions of the United States Department of Interior, Bureau of Land Management.

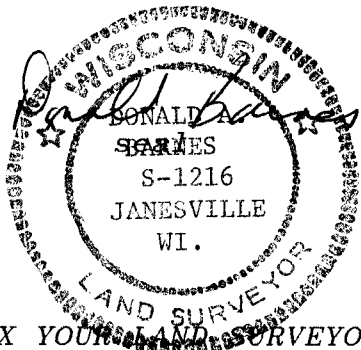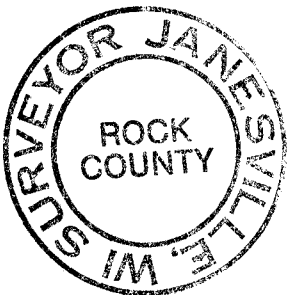

AFFIX YOUR SURVEYOR SEAL

COUNTY SURVEYOR FILING DATA

Date of computer entry _____

Date microfilmed _____

Number of included sheets _____

CORNER CODE