

PUBLIC LAND SURVEY MONUMENT RECORD

For Public Land Survey Corners in the


T. 13E N., R. 13E

CORNER CODE INDEX

	1	2	3	4	5	6	7	8	9	10	11	12	13	14	15	16	17	18	19	20	21	22	23	24	25
A																									
M																									
L																									
D																									
E																									
F																									
G																									
H																									
J																									
K																									
L																									
M																									
N																									
U																									
P																									
Q																									
H																									
T																									
U																									
V																									
W																									
X																									
Y																									
Z																									

PLACE MONUMENT SYMBOL (●) AT PROPER LOCATION ON ABOVE INDEX

EXAMPLE

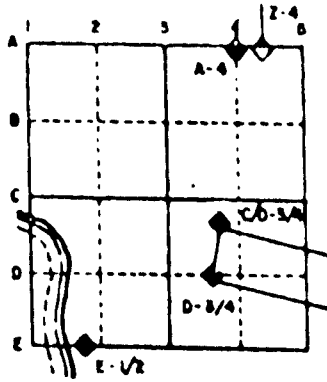

TURTLE TWP
ROCK COUNTY WI

IF AVAILABLE
STATE PLANE COORDINATES

North (Y) 227,061.47 Elev. (Z) _____
East (X) 522,693.12 Zone _____
Hor. Datum COUNTY Vert. Datum _____

◆ CORNER MONUMENT

○ WITNESS MONUMENT

Fd C. 1

Fd TIES IN VOL A pg 475

BEARINGS ARE BASED ON:

(B) Describe any record evidence, monument evidence, occupational evidence, testimonial evidence or any other material evidence you considered, and whether the monument was found or placed.

- 1836 LYON SET POST CORNER TO SECTIONS 12,11,&12. WHITE OAK 14 S42W 11 & BUR OAK 20 S13E 41. CALLS FOR 2649.24 TO S 1/4 COR SEC 2 & 2628.45 TO S 1/4 COR SEC 1.
- 1859 RUGER VOL 1 PG 91 OLD WITNESS TREES GONE TOOK NEW ONES(SAME AS PG 151).
- 1859 RUGER VOL 1 PG 92 VAR 5-20 TO S 1/4 COR SEC 1 & VAR 7-16 TO W 1/4 COR SEC 1.
- 1859 RUGER VOL 1 PG 93 CALLS FOR 2636.04 TO E 1/4 COR SEC 11.
- 1861 RUGER VOL 1 PG 151 WHITE OAK 36 S31-23E 157 1/4 & WHITE OAK 4 N46-37W 68', VAR 6-14 TO S 1/4 COR SEC 2 & VAR 7-16 E 1/4 COR 2.
- 1865 LOCKE VOL 1 PG 238 FOUND B TREES 2655.84 TO N 1/4 COR SEC 11 VAR 5-55, 2629.70 TO E 1/4 COR SEC 11.
- 1876 RUGER VOL 2 PG 202 CORNER ESTABLISHED BY SELF IN FORMER SURVEY. CALLS FOR 2655.84 TO S 1/4 COR SEC 2.
- 1882 HOLMES VOL 2 PG 354 FOUND LIMESTONE 1' UNDER SURFACE OF SOUTH SIDE OF ROAD BED. PLACED HH ON TOP COMING NEAR THE SURFACE. CALLS FOR 2650.56 TO W 1/4 COR SEC 1 & 2638.02 TO S 1/4 COR SEC 1.
- 1970 BATTERMAN VOL 4 PG 475 FOUND HH OVER LIMESTONE AT NE COR SEC 11. SET 4X30 C.I.
- 1974 WIDOT VOL 6 PG 55&120 FOUND C.I. NAD27 N/S 208,690.54;E/W 2,292,669.63.

FOUND CI. MONUMENT.

C) Was the corner restored through acceptance of (1) an obliterated evidence location, or, (2) a found perpetuated location?

ACCEPTED FOUND CI. MONUMENT.

D) Describe any material discrepancy between the location of the corner as restored or reestablished and the location of that corner as previously restored or reestablished by distance and direction. Show the discrepancy on the plan view drawing under (a), above. Show the distances between the corner as previously restored or reestablished and (1) the corner as restored or reestablished, and (2) to at least 4 of the witness monuments shown on the drawing in (a), above.

(E) Was the corner reestablished through lost corner proportionate methods? If so, show the method, including the directions and distances to other public land survey corners used as evidence or used for proportioning the corner location.

NO

I, Donald Barnes, hereby certify that the corner points as identified by the corner code index were, in a field survey on,1994, established, re-established, monumented, re-monumented, recovered or restored as expressed below and in conformance with the regulations and rules as required in the current manual of survey instructions of the United States Department of Interior, Bureau of Land Management.

seal

7/13/95
Donald Barnes

COUNTY SURVEYOR FILING DATA

Date of computer entry _____

Date microfilmed _____

Number of included sheets _____

CORNER CODE

EMBOSS LAND SURVEYOR SEAL

A-E 7.08 REQUIREMENT

E21