

U.S. PUBLIC LAND SURVEY MONUMENT RECORD


For Public Land Survey Corners in the
T. 3 N., R. 12 E.

CORNER CODE INDEX

	1	2	3	4	5	6	7	8	9	10	11	12	13	14	15	16	17	18	19	20	21	22	23	24	25
A																									
B																									
C	6																								
D		5																							
E			4																						
F				3																					
G	7																								
H		8																							
I																									
J																									
K																									
L	18																								
M		17																							
N																									
O																									
P	19																								
Q		20																							
R																									
S																									
T	50																								
U		29																							
V																									
W																									
X																									
Y	31																								
Z		32																							

PLACE MONUMENT SYMBOL (◆) AT PROPER LOCATION ON ABOVE INDEX

EXAMPLE

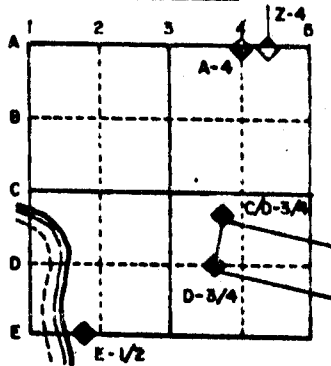

JAMESVILLE TWP
ROCK COUNTY WI

IF AVAILABLE STATE PLANE COORDINATES

North (Y) _____ Eleve. (Z) _____
 East (X) _____ Zone _____
 Hor. Datum _____ Vert. Datum _____

a.)


◆ CORNER MONUMENT

○ WITNESS MONUMENT

FOUND 4 HH IN A CIRCLE
PLACED POLY MON IN MIDDLE
WITH YELLOW CARSONITE ON NORTH SIDE

BEARINGS ARE BASED ON:

LIMITS OF EXCAVATION
THAT WAS 2.5' DEEP

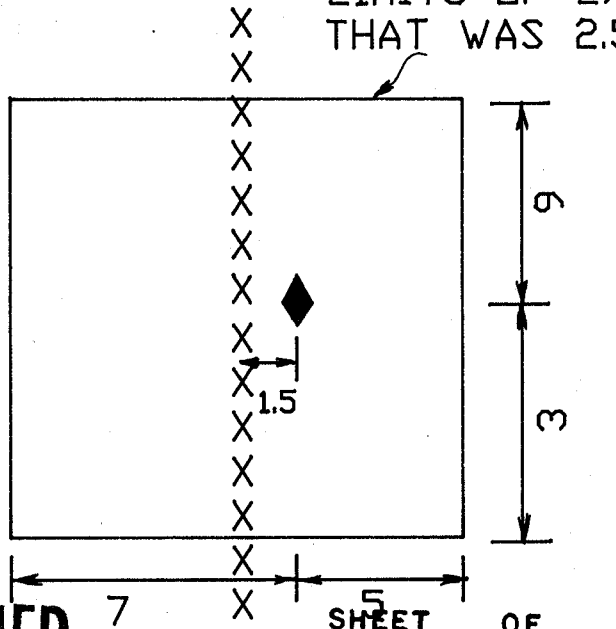

MICROFILMED

CORNER CODE: G 11

(b) Describe any record evidence, monument evidence, occupational evidence, testimonial evidence or any other material evidence you considered, and whether the monument was found or placed.

1866 LOCKE VOL 1 PG 250 PLACED STAKE SURROUNDED BY 4 HARDHEADS. DRAWING INDICATES THAT HE PROJECTED THE EAST LINE OF THE SE 1/4 OF SECTION 9 FROM THE MEANDER POST 38.28'. THIS WOULD HAVE BEEN THE LOCATION OF THE EAST QUARTER CORNER IF IT HAD NOT FALLEN IN THE RIVER. HE THEN PROBABLY PLACED THE CENTER OF SECTION ON LINE AND AT EQUAL DISTANCE WITH THIS AND THE WEST QUARTER CORNER OF SECTION 9. THE LAWS OF 1862 CALLED FOR THE CENTER OF SECTION TO PLACED EQUAL DISTANCE FROM THE NORTH AND SOUTH QUARTER CORNERS AND THE EAST AND WEST QUARTER CORNERS. SECTION 7 OF THAT LAW STATED THAT WHENEVER A QUARTER SECTION CORNER, AS ESTABLISHED BY THE U.S. SURVEY, CANNOT BE FOUND, IT SHALL BE SET IN THE MIDDLE OF THE SECTION LINE IN WHICH IT BELONGS, EXCEPT IN FRACTIONAL SECTIONS, IN WHICH CASE IT SHALL BE SET AT DISTANCES FROM THE SECTION OR MEANDER CORNERS BETWEEN WHICH IT BELONGS, WHICH ARE DIRECTLY PROPORTIONAL TO THE ENTIRE AND FRACTIONAL PARTS OF THE LINE, AS DETERMINED BY THE U.S. SURVEY. THE SURVEYOR SHALL ESTABLISH THE CENTER HIS MAP SHOWS A DISTANCE OF 2644.96 TO THE WEST QUARTER CORNER, 2656.50 TO THE SOUTH QUARTER CORNER, AND 2644.96 TO THE PROJECTED EAST QUARTER CORNER.

1987 SCHROEDER PLAT OF SURVEY. ESTABLISHED THE N/S QUARTER LINE AS A LINE BETWEEN THE NORTH AND SOUTH QUARTER CORNERS.

DUG A LARGE HOLE AND FOUND 4 HARDHEADS IN A CLOSE CIRCLE. THERE WERE NO OTHER HARDHEADS IN THE HOLE. PLACED POLY. MONUMENT IN MIDDLE OF HARDHEADS AND PLACED YELLOW CARSONITE POST ON NORTH SIDE. THE DISTANCE BETWEEN THE CENTER AND WEST QUARTER CORNER IS 2648.45 AND 2660.43 BETWEEN THE CENTER AND SOUTH QUARTER CORNERS. USING ALL OF LOCKE'S 1866 DISTANCES AND MEASURED DISTANCES THE PROPRATED DISTANCES ARE 2648.32 AND 2659.88.

(c) Was the corner restored through acceptance of (1) an obliterated evidence location, or, (2) a found perpetuated location?

ACCEPTED LOCKE'S HARDHEADS.

I, DONALD BARNES, hereby certify that the corner points as identified by the corner code index were, in a field survey on June 9, 1989, established, re-established, monumented, re-monumented, recovered or restored as expressed below and in conformance with the regulations and rules as required in the current manual of survey instructions of the United States Department of Interior, Bureau of Land Management.

