

PLAT AND RECORD

COUNTY BUILDING
IN CITY OF BELOIT


Of a Survey on Section 14 T 2 R 11 E. of the 4 P. M. in Plymouth Township

Rock County, Wisconsin, made Mar. 22 the 1921

I hereby certify that the following is a correct record of said survey as made by me.

(Signed) Alex W. Ely

County Surveyor.

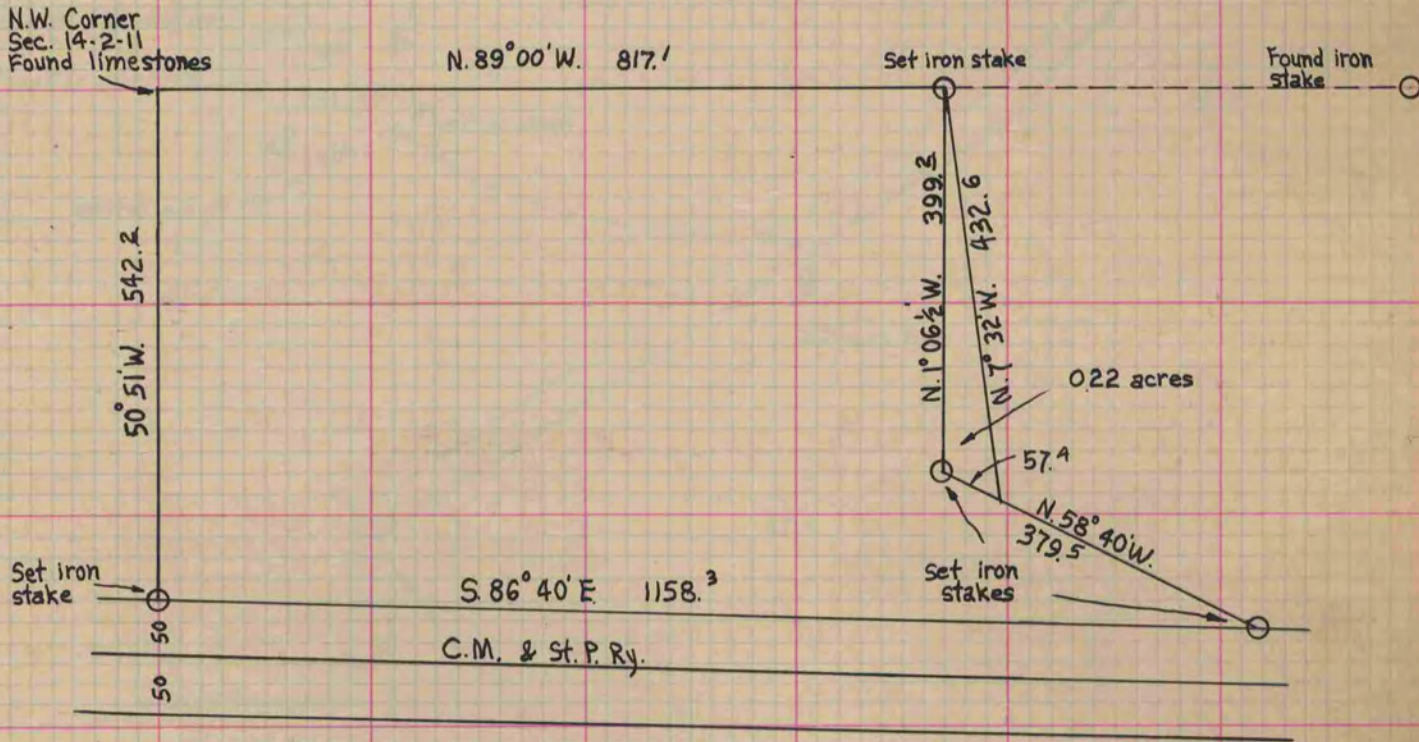

Mill Property
J.W. Flint - owner
Hanover, Wisc.