

PLAT AND RECORD

PG 188 JANESVILLE
REC 12/12/75
DAB


Of a Survey on Section 29 T 1 R 13 E. of the 4 P. M. in Turtle Township
Rock County, Wisconsin, made December the 31 1930

I hereby certify that the following is a correct record of said survey as made by me.

R. N. B.

County Surveyor.

COUNTY BUILDING
IN CITY OF БЕЛОIT

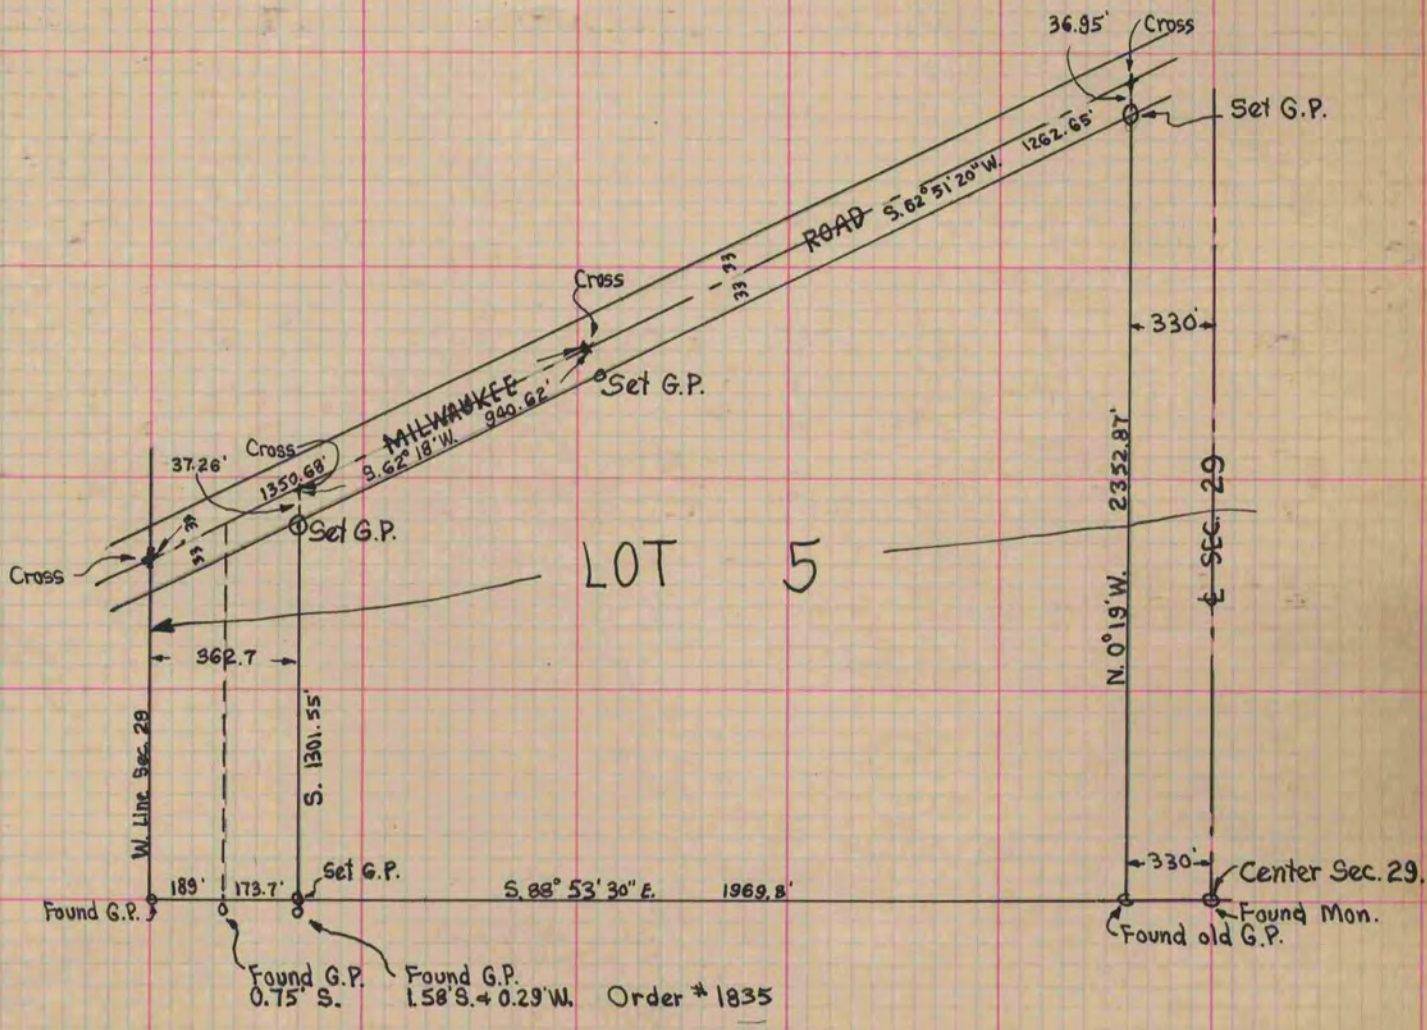

189
 173.7
 1969.8
 330.

 2662.5
 1381.25