

PLAT AND RECORD

Of a Survey on Section 22 T 7 R 12 E. of the 4 P. M. in Fulton Township


Rock County, Wisconsin, made March the 16th 1861

I hereby certify that the following is a correct record of said survey as made by me.

COUNTY BUILDING
IN CITY OF БЕЛОIT

(Signed) *Edward Ruger*
RMB

County Surveyor.

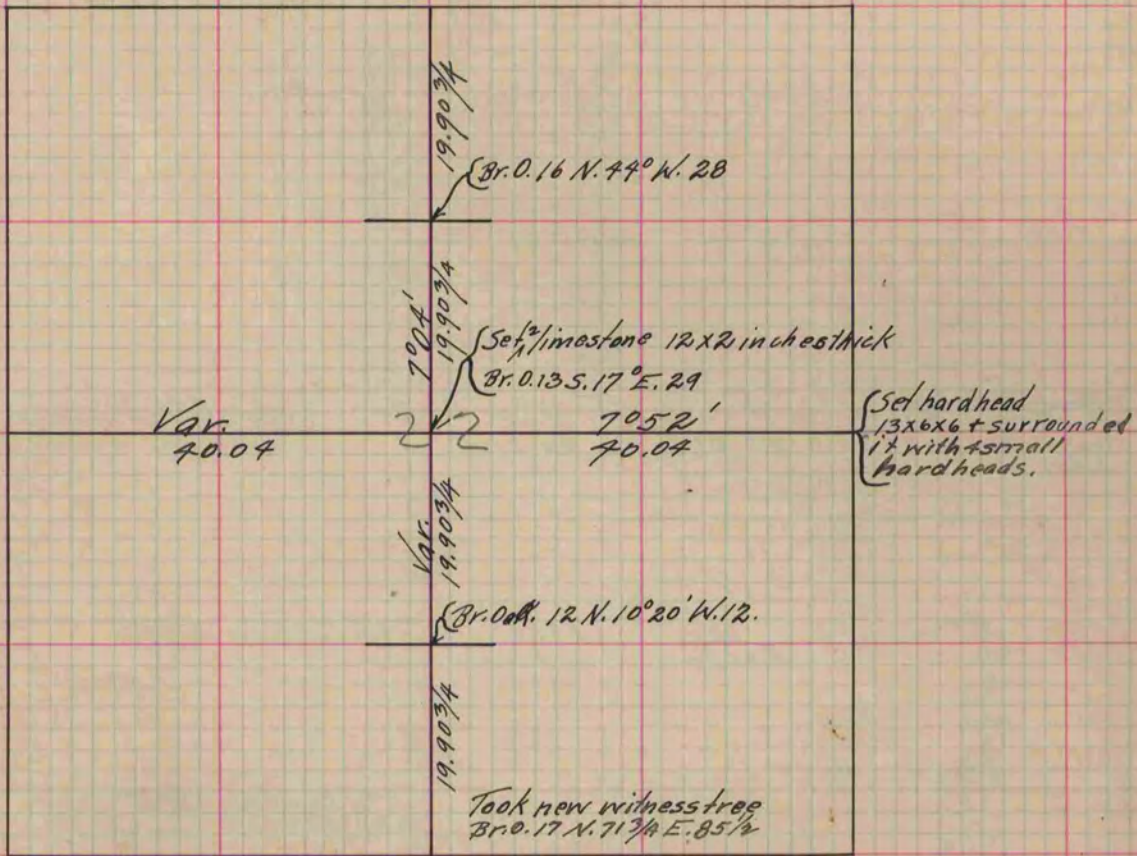

Copied from Page 163 Vol. 1. Original County Surveyor's Record.