


PLAT AND RECORD

Of a Survey on Section 22 T 3 R 13 E. of the 4 P. M. in HARMONY Township

Rock County, Wisconsin, made MAR. the 28 1963

I hereby certify that the following is a correct record of said survey as made by me.

COUNTY BUILDING
IN CITY OF BELOIT

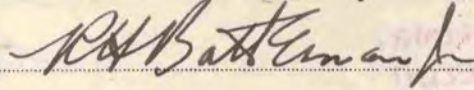

County Surveyor.

