


PLAT AND RECORD

Of a Survey on Section 3 T 1 R 13 E. of the 4 P. M. in Turtle Township
Rock County, Wisconsin, made March the 9th 1861

I hereby certify that the following is a correct record of said survey as made by me.

COUNTY BUILDING
IN CITY OF БЕЛОИТ

(Signed) Edward Ruger
ER County Surveyor.

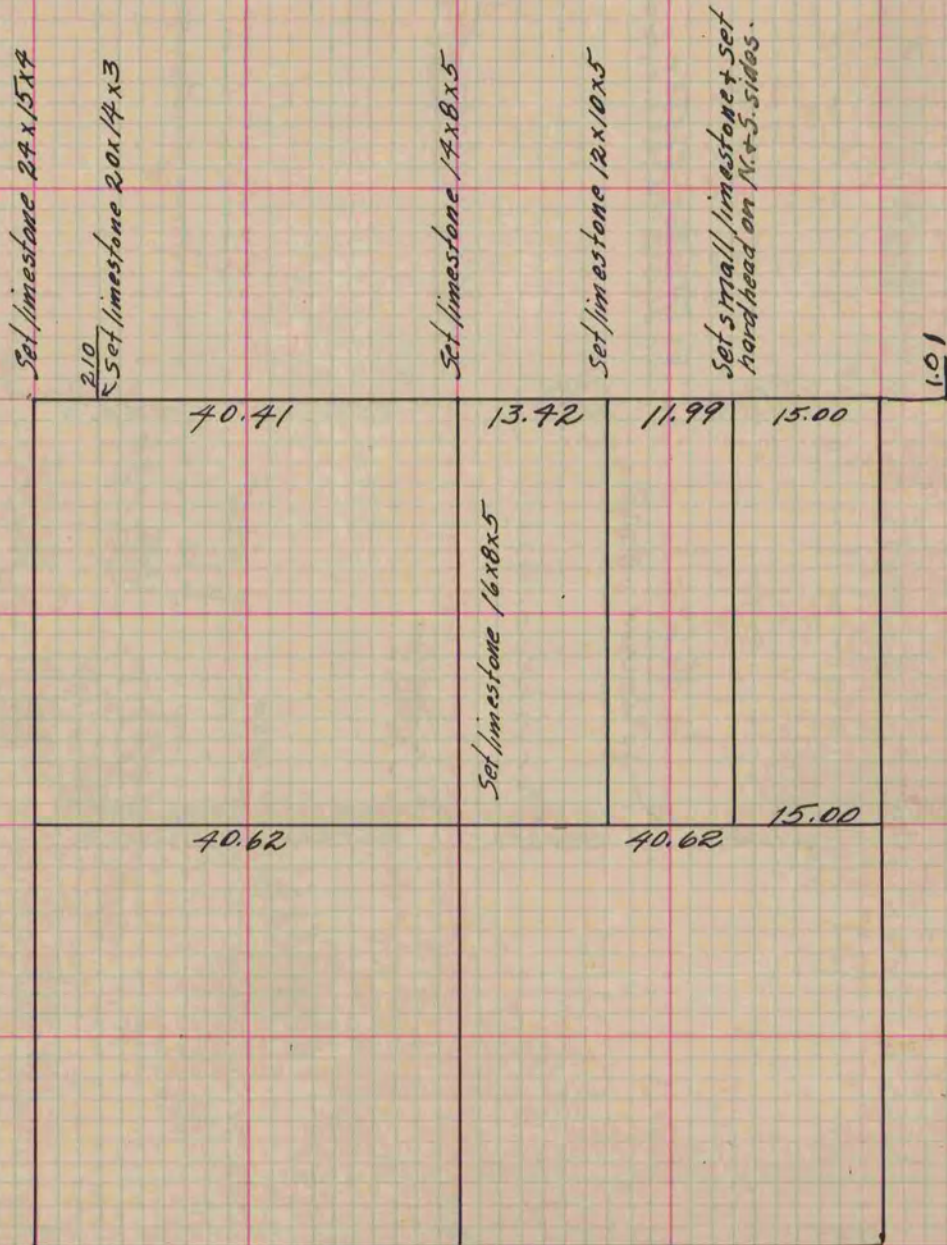

Copied from Page 161. Vol. 1. Original County Surveyor's Record.