

PLAT AND RECORD

Of a Survey on Section 35 T 3 R 13 E. of the 4 P. M. in Harmony Township


Rock County, Wisconsin, made February the 20th 1860

I hereby certify that the following is a correct record of said survey as made by me.

COUNTY BUILDING
IN CITY OF БЕЛОIT

(Signed) Edward Ruger
ERTB

County Surveyor.

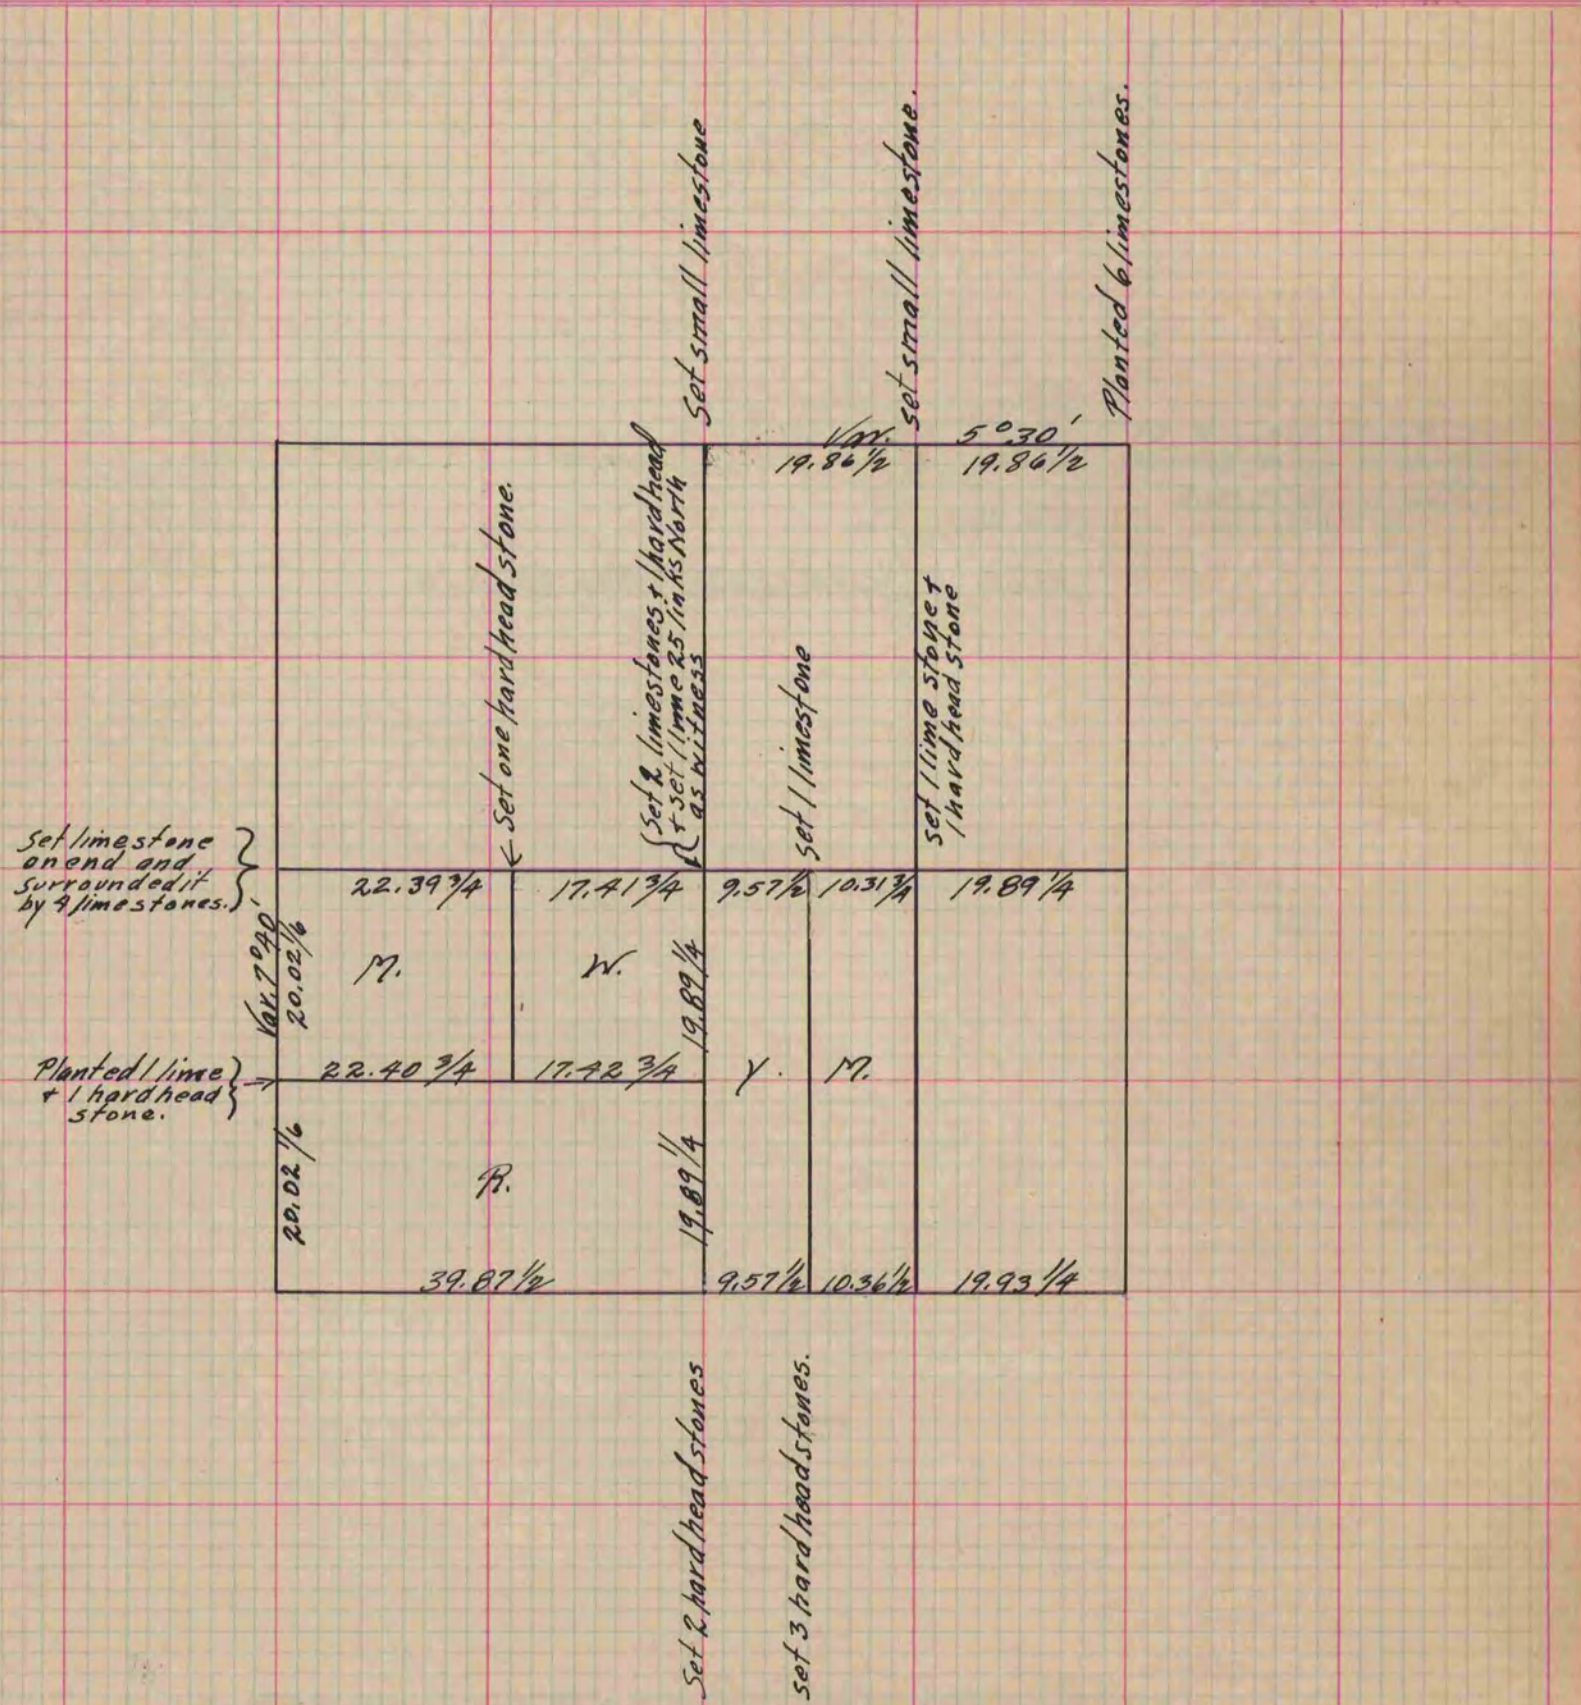

Copied from Page 134 Vol. 1. Original County Surveyor's Record.