

PLAT AND RECORD


Of a Survey on Section 25 T 2 R 11 E. of the 4 P. M. in Plymouth Township
Rock County, Wisconsin, made November the 25+26 1873

I hereby certify that the following is a correct record of said survey as made by me.

COUNTY BUILDING
IN CITY OF БЕЛОIT

(Signed) Edward Ruger
C.A.S.

County Surveyor.

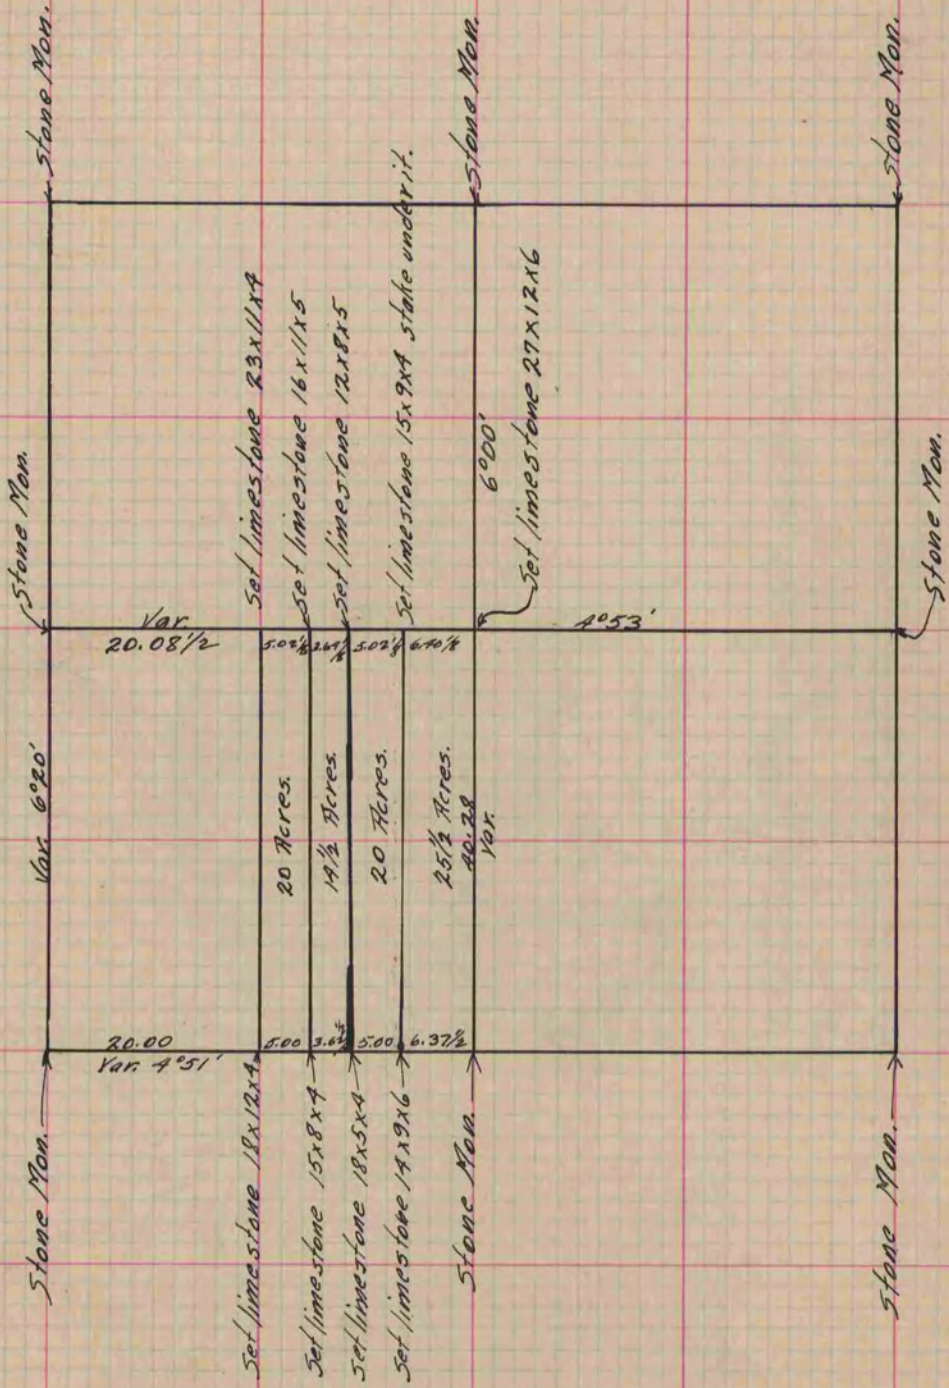

Copied from Page 73 Vol. 2 Original County Surveyor's Record.