

PLAT AND RECORD

Of a Survey on Section 34 T 2 R 11 E. of the 4 P. M. in Plymouth Township


Rock County, Wisconsin, made November the 21, 22 & 24 1873

I hereby certify that the following is a correct record of said survey as made by me.

COUNTY BUILDING
IN CITY OF BELOIT

(Signed) Edward Ruger
1873

County Surveyor.

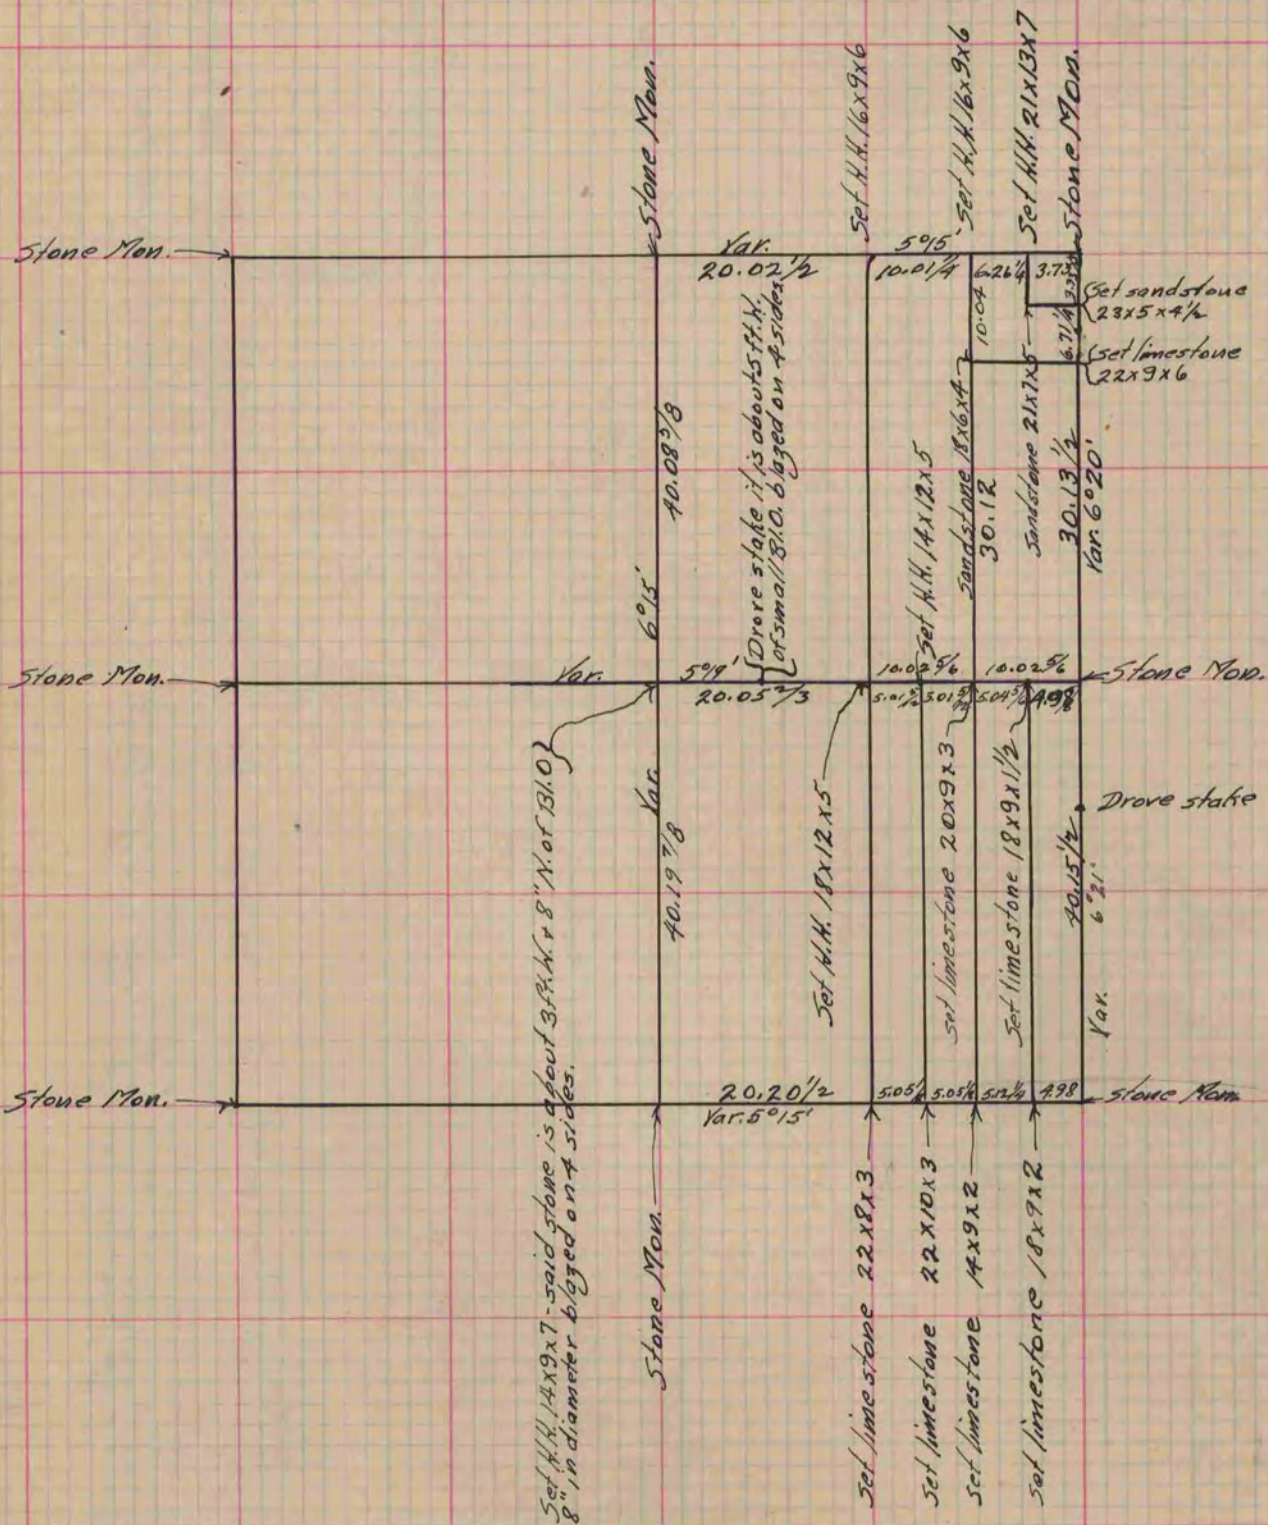

Copied from Page 72 Vol. 2. Original County Surveyor's Record.