

Paper weight-110# (minimum)

Black nonfading ink required

U.S. PUBLIC LAND SURVEY MONUMENT RECORD

For Public Land Survey Corners In:
T. 4 N. R. 11 E. 4th P.M.
CORNER CODE INDEX

WI ADMINISTRATIVE CODE A-E 7.08 REQUIREMENT
REV 10/23/2004 USMONREC.DWG

PORTER TWP
ROCK COUNTY WI

IF AVAILABLE
ROCK COUNTY COORDINATES PREFERRED

| | | | | | | | | | | | | | | | | | | | | | | | | | | |
|---|---|---|---|---|---|---|---|---|---|----|----|----|----|----|----|----|----|----|----|----|----|----|----|----|----|---|
| A | 1 | 2 | 3 | 4 | 5 | 6 | 7 | 8 | 9 | 10 | 11 | 12 | 13 | 14 | 15 | 16 | 17 | 18 | 19 | 20 | 21 | 22 | 23 | 24 | 25 | A |
| B | | 6 | | | | | 5 | | | | 4 | | | | 3 | | | 2 | | | | 1 | | | | B |
| C | | | | | | | | | | | | | | | | | | | | | | | | | | C |
| D | | | | | | | | | | | | | | | | | | | | | | | | | | D |
| E | | | | | | | | | | | | | | | | | | | | | | | | | | E |
| F | | | | | | | | | | | | | | | | | | | | | | | | | | F |
| G | | | | | | | | | | | | | | | | | | | | | | | | | | G |
| H | | | | | | | | | | | | | | | | | | | | | | | | | | H |
| J | | | | | | | | | | | | | | | | | | | | | | | | | | J |
| K | | | | | | | | | | | | | | | | | | | | | | | | | | K |
| L | | | | | | | | | | | | | | | | | | | | | | | | | | L |
| M | | | | | | | | | | | | | | | | | | | | | | | | | | M |
| N | | | | | | | | | | | | | | | | | | | | | | | | | | N |
| O | | | | | | | | | | | | | | | | | | | | | | | | | | O |
| P | | | | | | | | | | | | | | | | | | | | | | | | | | P |
| Q | | | | | | | | | | | | | | | | | | | | | | | | | | Q |
| R | | | | | | | | | | | | | | | | | | | | | | | | | | R |
| S | | | | | | | | | | | | | | | | | | | | | | | | | | S |
| T | | | | | | | | | | | | | | | | | | | | | | | | | | T |
| U | | | | | | | | | | | | | | | | | | | | | | | | | | U |
| V | | | | | | | | | | | | | | | | | | | | | | | | | | V |
| W | | | | | | | | | | | | | | | | | | | | | | | | | | W |
| X | | | | | | | | | | | | | | | | | | | | | | | | | | X |
| Y | | | | | | | | | | | | | | | | | | | | | | | | | | Y |
| Z | | | | | | | | | | | | | | | | | | | | | | | | | | Z |

North _____ Elev. _____
 East _____
 Hor. Datum _____ Vert. Datum _____
 LATITUDE _____ ELLIPS. HT. _____
 LONGITUDE _____
 NAD83(91) _____ NETWORK ADJ. YR _____
 GPS (X) _____ TRAVERSE (X) _____
 BASED ON THE FOLLOWING CONTROL:

1 2 3 4 5 6 7 8 9 10 11 12 13 14 15 16 17 18 19 20 21 22 23 24 25
PLACE MONUMENT SYMBOL AT PROPER LOCATION ON ABOVE INDEX

CORNER MONUMENT WITNESS MONUMENT

BEARINGS ARE BASED ON: -----

FIELD BOOK _____ PAGE # _____ SHEET 1 OF 33
 SHOW A PLAN VIEW DRAWING DEPICTING THE CORNER MONUMENT AND SURROUNDING PHYSICAL FEATURES, INCLUDING THE EXCAVATION AREA AND DEPTH.
 PLANNING & ZONING COMMITTEE ADOPTED THIS FORM ON 12/2/1982
 CORNER CODE R-15

PO588 S1/4CORSEC22

(B) Describe any record evidence, monument evidence, occupational evidence, testimonial evidence or any other material evidence you considered, and whether the monument was found or placed.

- 1833 HARRISON (NOV) T4N R11E 4TH MER. EAST ON RAND.
BET. 22 & 27
2640.0 QUARTER SEC COR. (TEMPORARY)
2772.0 BROOK 5.28' CRS NORTH
5247.0 INT. E BDY 2ND RATE WITH WHITE OAK RED
OAK & BURR OAK TIMBER
WEST COR. WEST BET
2623.50 QUARTER SEC COR
{WHITE OAK 18 N55E 91.74'; WHITE OAK 24
N25W 36.30' {WHITE OAK 18; WHITE OAK
24} MARKED
5247.00 SEC COR
- 1878 RUGER VOL 2 PG 241 FD OLD STAKE, ALSO FD N.W. B.T NE.
BT GONE. DROVE STAKE & SURROUNDED IT BY 4 SMALL HH
STONES. VAR 7-36 1312.08 TO S 1/16TH COR OF SE 1/4
SEC 22, 2624.16 TO SE COR SEC 22, VAR 6-19 TO N 1/4
COR SEC 22
- 1957 BATTERMAN CSM VOL 1 PG 3 FD OAK STAKE SURROUNDED
BY STONES DROVE PIPE, SOUTHERLY 785.07 TO PIPE ON
SEC LINE & NORTH R/W LINE
- 1979 BARNES VOL 5 PG 548 (KARNS SURVEY) N89-55-16E
2635.726 (PRORATED) TO SE COR SEC 22.
- 1979 KARNS VOL 6-279 2635.73 TO NE COR SEC 27.
- 1982 BARNES VOL 6 PG 277 FD IP AS CALLED FOR IN COUNTY
SURVEYORS' RECORDS. REPLACED WITH POLYSTRENE
MON. & SET CARSONITE.
- 1982 BARNES VOL 6 PG 279 S89-55-38E 2635.82 TO NE COR
SEC 27.
- 1983 BARNES #6841 FD ALUM MON N89-55-38E TO ALUM @ NE
COR SEC 27; S00-07-23W TO POLY MON @ S 1/4 COR SEC
27
- 1989 SCHROEDER CSM VOL 13 PG 493 STATES NOTHING ABOUT
MON. S89-28-55E 1315.11 ALONG SEC LINE, S00-07-23W
783.70 TO PIPE ON NORTH R/W OF RD
- 1998 COMBS #8358 FD ALUM. MON. 5310.04 TO ALUM @ N 1/4
COR SEC 20. 3548.83 TO PIPE ON SEC LINE @ NORTH R/W
OF CTH M.
- 2000 COMBS #7655 FD ALUM. N89-34-37W 1317.96 TO 1/16TH
COR, S89-34-37E 2635.92 TO ALUM @ SE COR SEC 22.
ALUM MON N89-38-38W 2587.42 TO ALUM @ SW COR SEC
22
- 2004 LATHROP #14877 FD ALUM. MON. S89-31-05E 1315.22 TO
FD PIPE.

I USED MY 1982 OBSERVATIONS TO POLYSTRENE MON.

SHEET 1 OF 2
CORNER CODE R-15

Donald Barnes
3/17/2009

PO588

S 1/4 CORSEC22

C) Was the corner restored through acceptance of (1) an obliterated evidence location, or, (2) a found perpetuated location?

ACCEPTED POLY. MON.


D) Describe any material discrepancy between the location of the corner as restored or reestablished and the location of that corner as previously restored or reestablished by distance and direction. Show the discrepancy on the plan view drawing under (a), above. Show the distances between the corner as previously restored or reestablished and (1) the corner as restored or reestablished, and (2) to at least 4 of the witness monuments shown on the drawing in (a), above.

NO

(E) Was the corner reestablished through lost corner proportionate methods? If so, show the method, including the directions and distances to other public land survey corners used as evidence or used for proportioning the corner location.

NO

I, **Donald Barnes**, hereby certify that the corner location as identified by the corner code index was determined by me under my direction and control and that this U.S. Public Land Survey Monument Record is correct and complete to the best of my knowledge and belief.


Seal
Barnes
Emboss

SHEET 2 OF 3

3/17/2007

CORNER CODE **R-15**

A.E. 7.08 REQUIREMENT

W 1/4 COR

POLY

N89-16-19E 5243.01

E 1/4 COR

CI

N00-40-54W 2662.11
2002 KARNs CSM25-225 2661.08
2000 KARNs #7606 N00-15-46W 2662.14
1833 HARRISON 2640.00

1833 HARRISON 2640.00
1979 KARNs 5-548 N0-29-02E 2649.33
N00-15-37W 2649.30

S44-59-07E 3704.92

89-45-50
89-47-35

SEC 22

180-05-46
2.19 NORTH
OF SW-SE LINE

N89-04-55E 2587.74
N89-38-38E 2587.42
2000 COMBS #7655 (OCT31) HARRISON 2623.50

1833 (OCT31) HARRISON 2623.50
1878 RUGER 2-241 VAR7-36 2624.16
1979 KARNs 5-548 S89-55-16W 2635.76
1982 BARNES 6-279&6841 S89-55-38E 2635.82
2000 COMBS #7655 2635.92
N89-10-42E 2635.80

SE COR

ALUM

POLY

1321.61
N0-02-56E
1992 BARNES 6-428
N00-56-39E 1321.60
1833 HARRISON 2640.00

1833 HARRISON 2640.00
1979 KARNs 5-548 S00-08-29E 2649.33
N00-00-02W 2649.33
N00-53-48W 2649.46

SEC 27

1833 (OCT31) HARRISON 2623.50
1878 RUGER 2-241 VAR7-36 2624.16
1979 KARNs 5-548 S89-55-16W 2635.76
1982 BARNES 6-279&6841 S89-55-38E 2635.82
2000 COMBS #7655 2635.92
N89-10-42E 2635.80

SE COR

ALUM

1321.61
N0-02-56E
1992 BARNES 6-428
N00-56-39E 1321.60
1833 HARRISON 2640.00

1833 (OCT31) HARRISON 2623.50
1878 RUGER 2-241 VAR7-36 2624.16
1979 KARNs 5-548 S89-55-16W 2635.76
1982 BARNES 6-279&6841 S89-55-38E 2635.82
2000 COMBS #7655 2635.92
N89-10-42E 2635.80

SE COR

ALUM

SEC 27

1833 (OCT31) HARRISON 2623.50
1878 RUGER 2-241 VAR7-36 2624.16
1979 KARNs 5-548 S89-55-16W 2635.76
1982 BARNES 6-279&6841 S89-55-38E 2635.82
2000 COMBS #7655 2635.92
N89-10-42E 2635.80

SE COR

ALUM

PIPE

1/16TH COR

SHEET 3 OF 3

R-15

S 1/4 COR

SEC 22


PORTER TWP

T4N R11E

S76-39-49E 5411.47

E 1/4 COR


ALUM

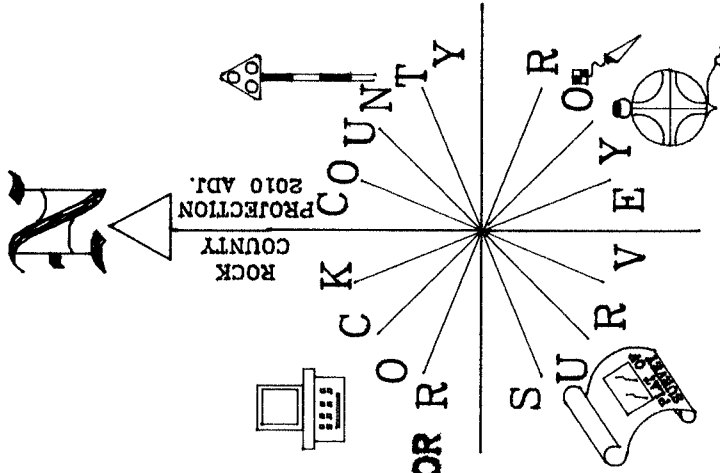

ROCK COUNTY
PROJECTION
2010 ADJ.

C O U N T Y

S U R V E Y

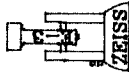

NOT TO SCALE

OBSERVATION SHEET #107

EMBOSSSED SEAL
Handwritten signature: Paul Barnes