

Paper weight-110# (minimum)

Black nonfading ink required

U.S. PUBLIC LAND SURVEY MONUMENT RECORD

For Public Land Survey Corners In:

WI ADMINISTRATIVE CODE A-E 7.08 REQUIREMENT

T. 4 N. R. 12 E. 4th P.M.

REV 10/23/2004

USMONREC.DWG

CORNER CODE INDEX

FULTON TWP
ROCK COUNTY WI

IF AVAILABLE
ROCK COUNTY COORDINATES PREFERRED

North _____ Elev. _____

East _____

Hor. Datum _____ Vert. Datum _____

LATITUDE _____ ELLIPS. HT. _____

LONGITUDE _____

NAD83(91) _____ NETWORK ADJ. YR _____

GPS (X) _____ TRAVERSE (X) _____

BASED ON THE FOLLOWING CONTROL:

1	2	3	4	5	6	7	8	9	10	11	12	13	14	15	16	17	18	19	20	21	22	23	24	25	
A																									A
B	6					5					4				3					2				1	B
C																									C
D																									D
E																									E
F																									F
G	7					8					9				10					11				12	G
H																									H
J																									J
K	18					17					16				15					14				13	K
L																									L
M																									M
N																									N
O																									O
P	19					20					21				22					23				24	P
Q																									Q
R																									R
S																									S
T	30					29					28				27					26				25	T
U																									U
V																									V
W																									W
X	31					32					33				34					35				36	X
Y																									Y
Z																									Z

PLACE MONUMENT SYMBOL AT PROPER LOCATION ON ABOVE INDEX

CORNER MONUMENT

WITNESS MONUMENT

BEARINGS ARE BASED ON: _____

FIELD BOOK _____ PAGE # _____

SHEET 1 OF 2

SHOW A PLAN VIEW DRAWING DEPICTING THE CORNER MONUMENT AND SURROUNDING PHYSICAL FEATURES, INCLUDING THE EXCAVATION AREA AND DEPTH.

PLANNING & ZONING COMMITTEE ADOPTED THIS FORM ON 12/2/1982

CORNER CODE P-17

FU579 ^

(B) Describe any record evidence, monument evidence, occupational evidence, testimonial evidence or any other material evidence you considered, and whether the monument was found or placed.

- 1836 (JULY) BURNHAM NORTH BETWEEN SECTIONS 23 & 24
 - 1282.38 BUR OAK 12 IN DIA
 - 2640 SET 1/4 SEC POST W. OAK 16 S28 1/2W 50.82'? NO OTHER BEARING NO STATIONS
 - 5280 SET POST COR TO 13,14,23,24 BUR OAK 12 N5 1/2E 25.08' BUR OAK 12 S14 1/2W 16.5' FIRST RATE W. Y. & BUR OAK OPENINGS
- 1885 RUGER VOL 2 PG 383 SET SANDSTONE 22X10X4 & PUT SMALL HH ON W SIDE & TOOK BT BL O B S4 1/2E 4.46', VAR 5-32 2651.88 TO NE COR SEC 23, VAR 6-27 2648.58 TO SE COR SEC 23.
- 18?? ???? #1332 SANDSTONE 21X9X7 SURROUNDED 4 SMALL HH 2614.14 TO SE COR SEC 23
- 1896 BROWN VOL 2 PG 501 FD COR OF LOCKE SET HH L11X8X6 PUT HH ON E & W.
- 1956 SUNNY #1335 FD 8"X8" WOOD POST DEEP. 206.5 WEST OF CENTER OF TOWN RIVER RD.
- 1978 BARNES VOL 5 PG 486 SET ALUM. MON 1312.72 TO SANDSTONE @ W 1/16TH COR OF NW 1/4 OF SEC 24, 1386.29 TO FD PIPE @ W 1/16 TH COR OF SW 1/4 OF SEC 24. DUG 2.5' X10 HOLE & FD NOTHING. MON IS 2 WEST OF N/S FENCE & 4' NORTH OF E/W FENCE. WAS ESTABLISHED BY PROJECTING THE NW COR OF SEC 24 & AND THE SANDSTONE & BY PROJECTING THE IP OF THE CSM AND IP 631 NORTH OF THAT. THE CORNER WAS SIDE MIDWAY BETWEEN THE TWO LINES. THIS IS 1.39' WEST OF A POINT THAT WOULD BE ON A STRAIGHT LINE BETWEEN THE NW & THE IP OF THE CSM.
- 1985 COMBS #13610 STATES NOTHING ABOUT MON.
- 1992 COMBS CSM VOL 16 PG 8 ALUM. 207.88 WEST OF CENTER OF RD.

USED 1978 OBSERVATIONS

C) Was the corner restored through acceptance of (1) an obliterated evidence location, or, (2) a found perpetuated location?

ACCEPTED ALUM. MON.

D) Describe any material discrepancy between the location of the corner as restored or reestablished and the location of that corner as previously restored or reestablished by distance and direction. Show the discrepancy on the plan view drawing under (a), above. Show the distances between the corner as previously restored or reestablished and (1) the corner as restored or reestablished, and (2) to at least 4 of the witness monuments shown on the drawing in (a), above.

NONE

(E) Was the corner reestablished through lost corner proportionate methods? If so, show the method, including the directions and distances to other public land survey corners used as evidence or used for proportioning the corner location.

I, Donald Barnes, hereby certify that the corner location as identified by the corner code index was determined by me under my direction and control and that this U.S. Public Land Survey Monument Record is correct and complete to the best of my knowledge and belief.

Seal
Donald Barnes

Emboss
Barnes


11/18/07

SHEET 1 OF 2

CORNER CODE

A.E. 7.08 REQUIREMENT

P 21

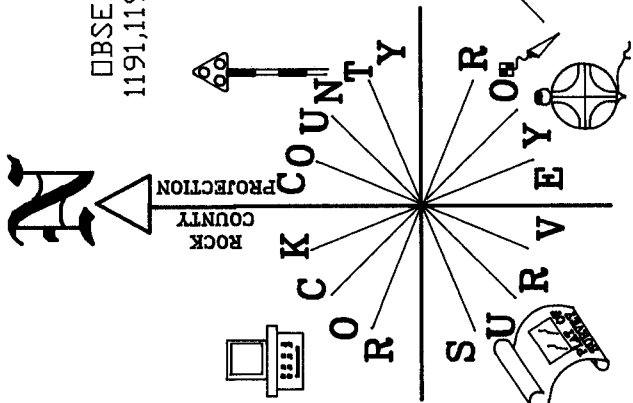

OBSERVATION SHEETS:
1191,1194,1195,1196,& 1203

ROCK COUNTY
PROJECTION



3/4X24 RERDD
CREST OF R/W SLOPE
ON SOUTH SIDE OF CTH M
UNDER 3 E/W WIRES
2' NORTH OF 3RD NORTH
WIRES EAST SIDE OF SLOPE

NOT TO SCALE



FULTON TWP
TAN RISE

FD SANDSTONE

SEC 23
N45-50-16E 4093.46

E 1/4 CDR
SEC 23

ALUM 1956 206.5
1992 207.88

SEC 24

KIDDER RD

CENTER OF PVMT

N00-08-43W 1312.74

N15-21-49W 2262.96
810861 W25-35-40N

N00-14-00W 2017.58
N18-47-08E 1830.39

N43-40-35E 2497.73
N62-21-57E 3318.39

CTH M
S77-35-27E 1244.02

N86-17-29E 1137.84

S72-26-16E 795.58

CTH M

N74-29-47E 564-05-17E

478.60

FD 1" PIPE
SOUTH SIDE
CTH M
3/4X24 RERDD
IN DITCH LINE
NORTH SIDE RD

DURA NAIL
IN DRIVEWAY TO
FARM HOUSE
0.3' WEST
OF EAST PVMT EDGE

3/4X24 RERDD
SOUTH SIDE RD
17.5' NORTH
OF UP #2D23R6A

3/4X24 RERDD
11.5 NORTH
OF NORTH PVMT EDGE
22' SW OF GUY
WIRE THAT IS
BY SIGN
300 +/- WEST OF
RD INT.

2 OF 2 SHEETS

P-21

Donald James
11/18/07
EMBOSSED SEAL