


Found corners as set by self
in survey of sec. 15 center

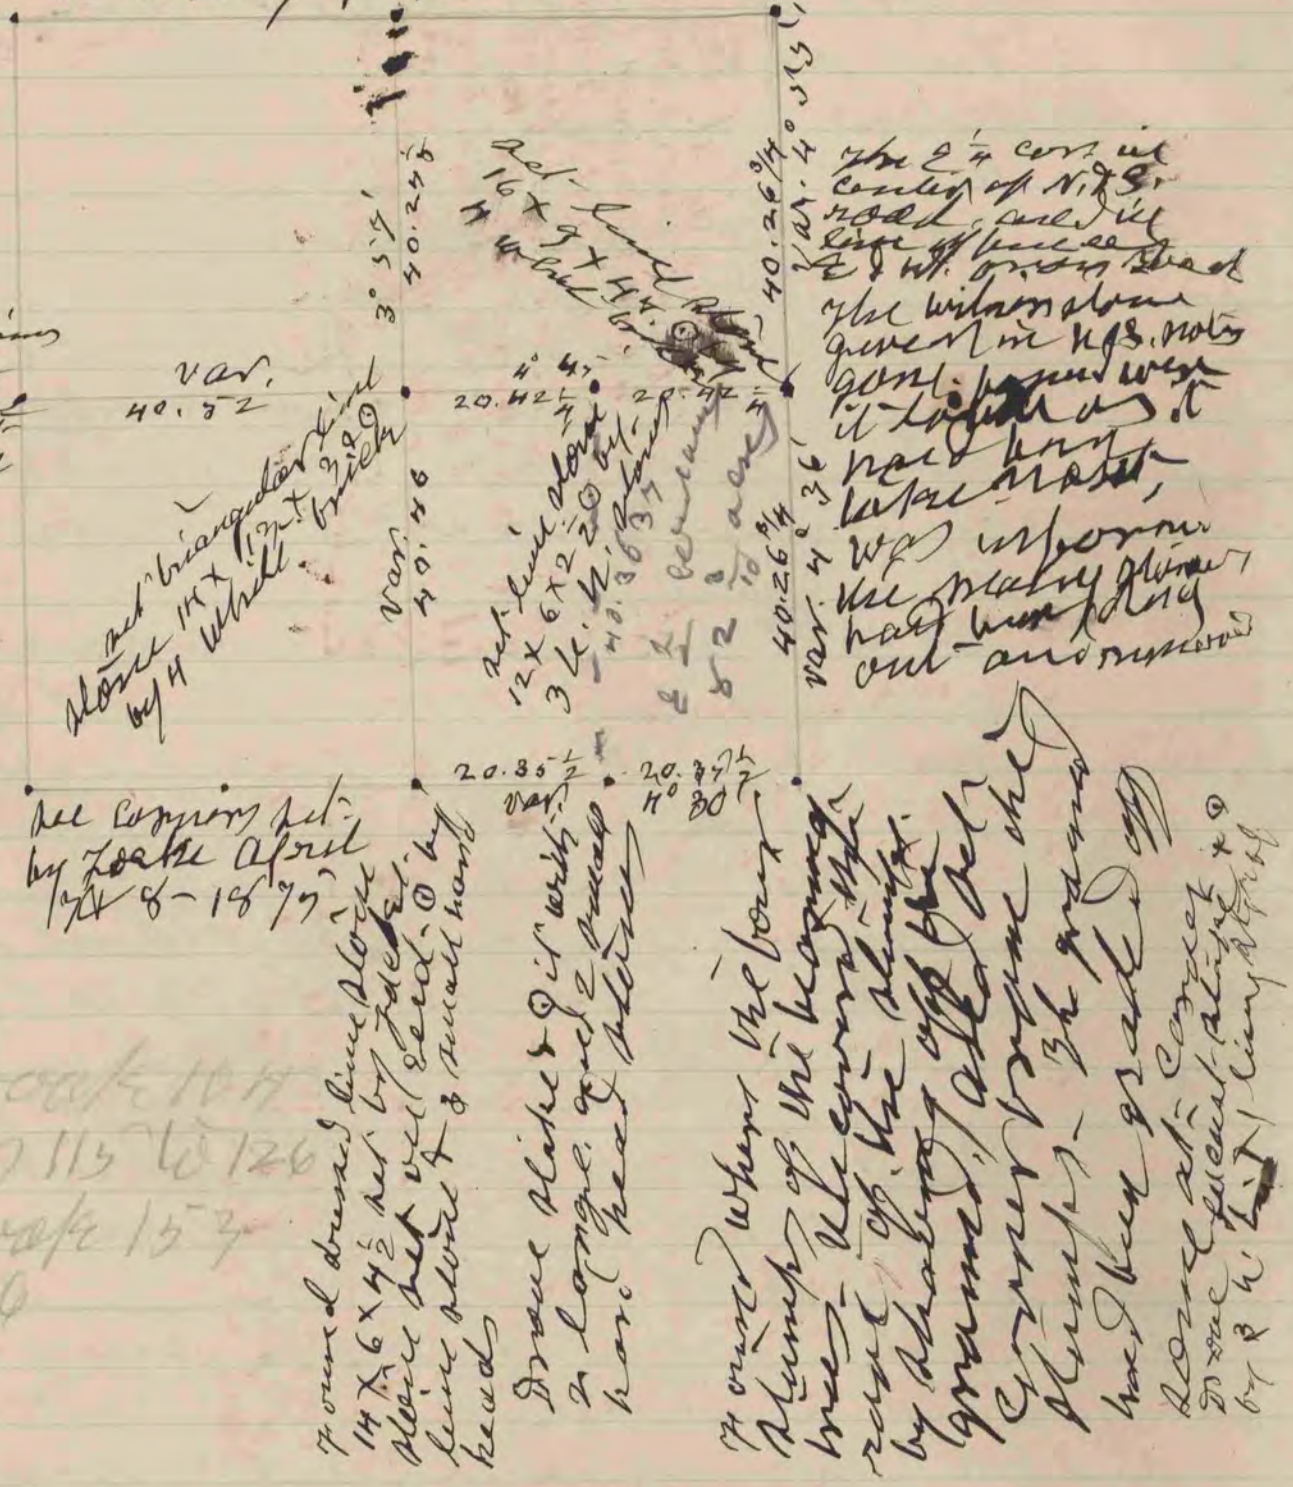

COUNTY SURVEYOR
RECORD 1859-1906

see book 104
pages 113 to 126
also book 153
page 60

The above is a record and plat of
a survey made by me on Dec. 22
center Nov. 8 & 9, 1905
Edward Rogers surveyor