


Rec Vol 2  
Pg 420

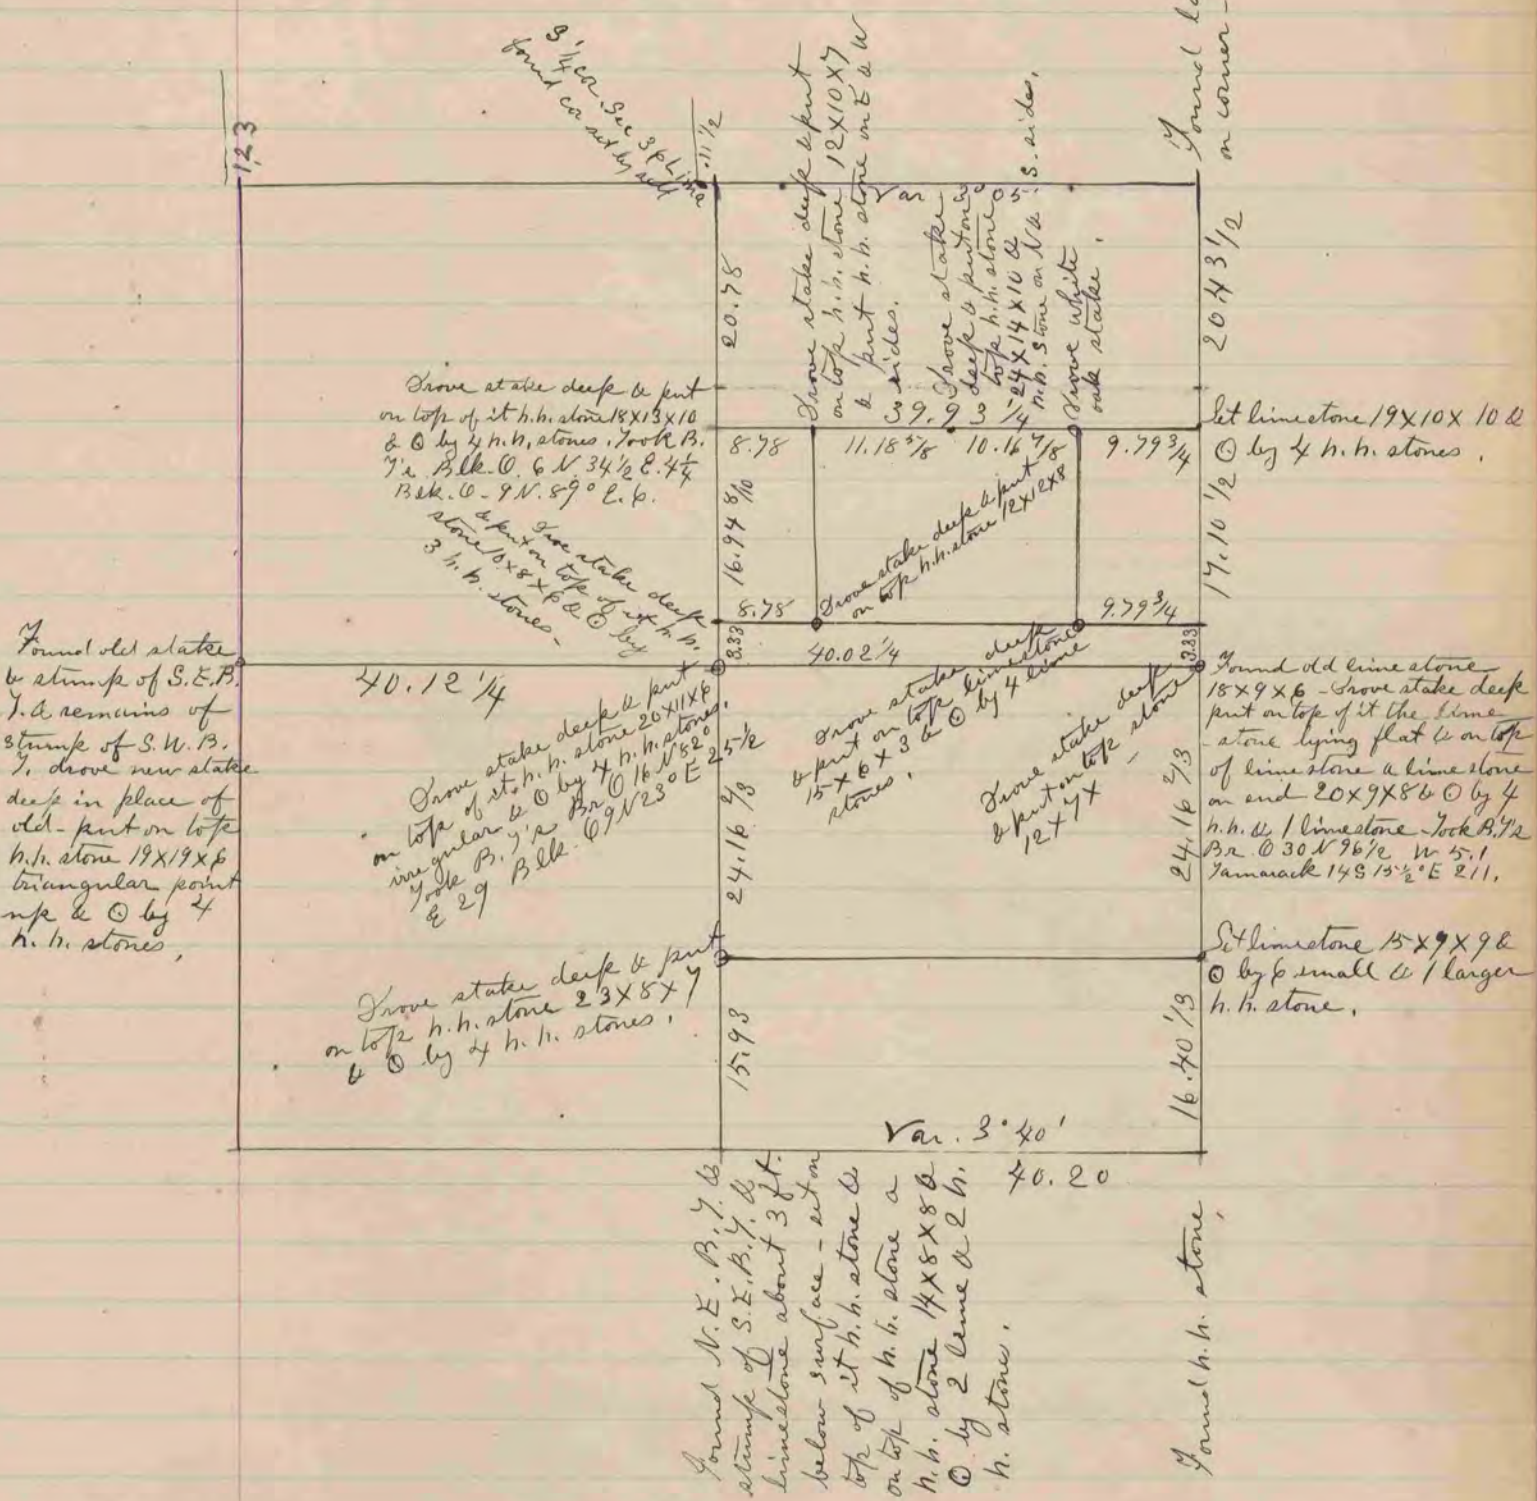

The above is a record & plat of a survey made by me on Sec. 1 Johnstown - Dec - 6<sup>th</sup> 1887

COUNTY SURVEYOR  
RECORD 1859-1906