


The above is a record & plat of a Survey made by me
Nov. 26th & 27th 1883 on Sec - 31. Fulton
R. K. Lee Dept. Co. Surveyor.

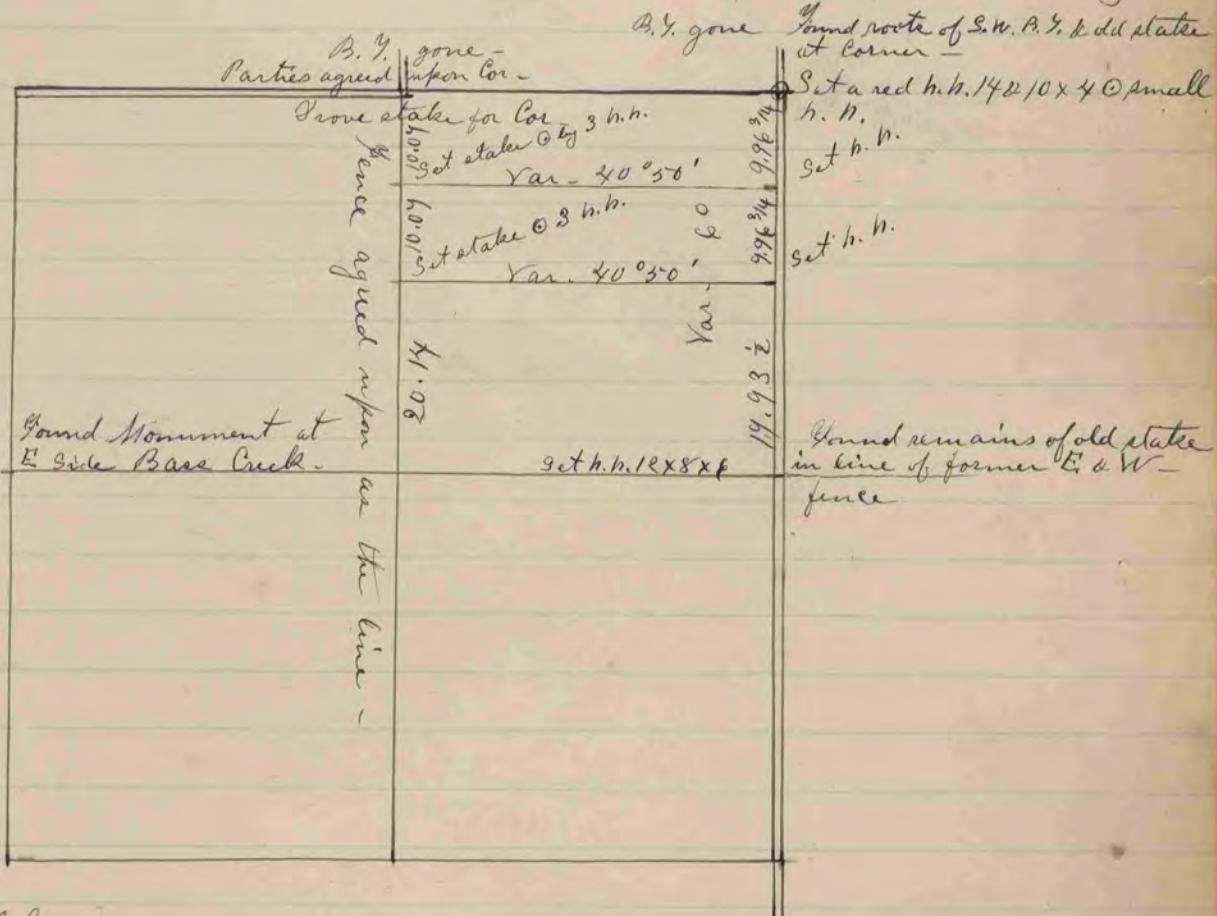

The above is a record & plat of a Survey made by me
Dec. 8th & 9th 1883 on Sec. 19 Rock.
R. K. Lee Dept. Co. Surveyor.