


Channel h. h. at cor -

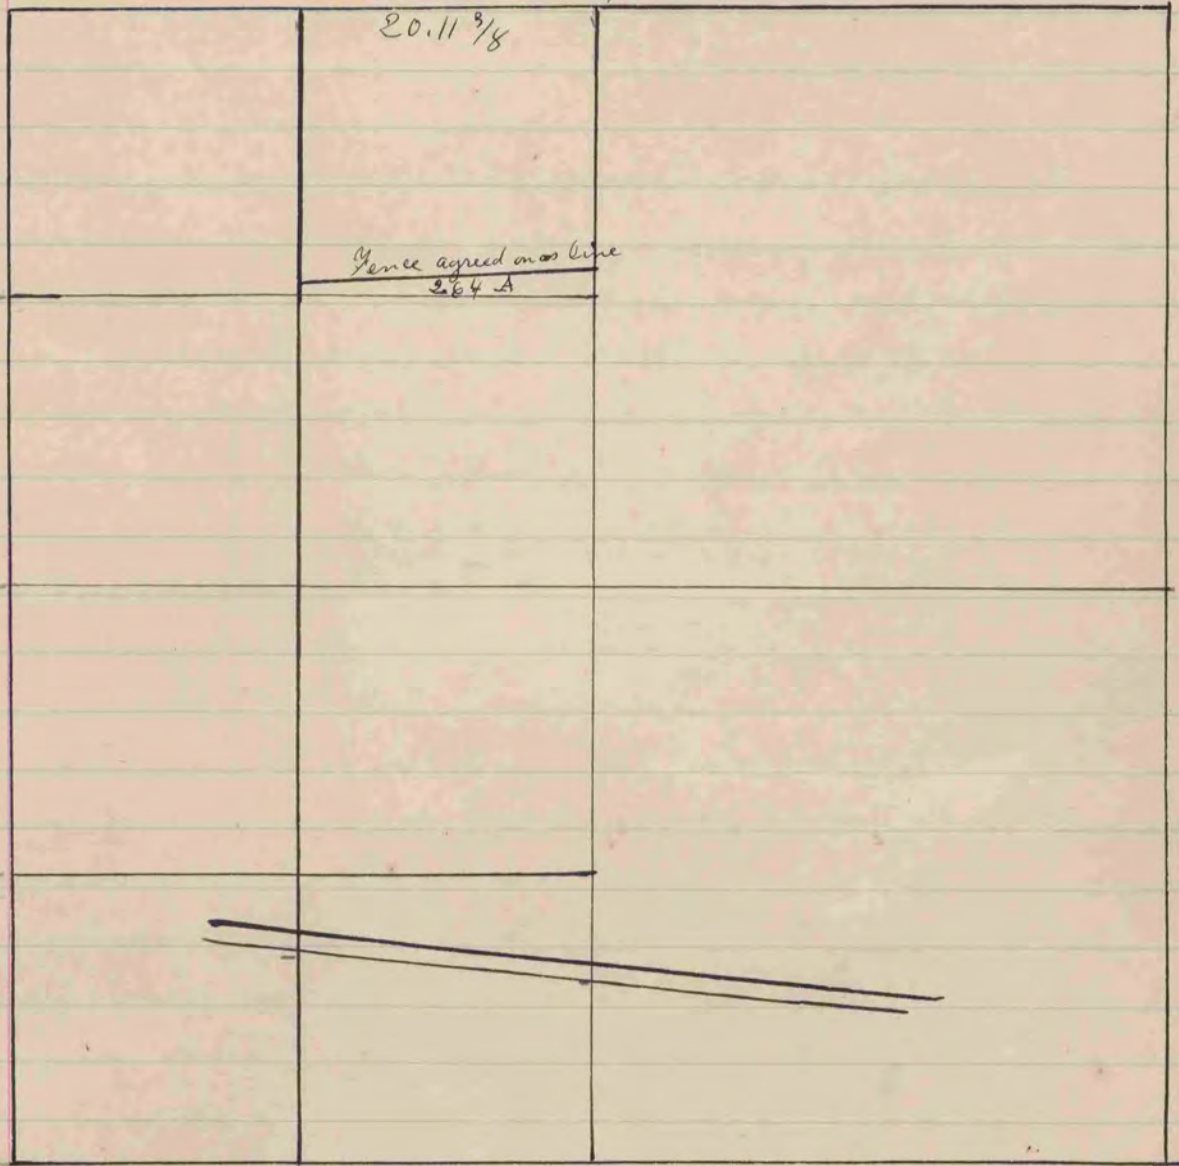

The above is a record & plat of a Survey made  
 by me June 7<sup>th</sup> - 8<sup>th</sup> 1887 on Sec. 6 Bradford -  
 R. K. Lee  
 Dept. Co. Surveyor -