


Found N.E. B. 7. & where
stump of S.E. B. 7. had
been dug up. also old
fence post hole - Set
limestone 27x8x4 &
O by 4 limestone.

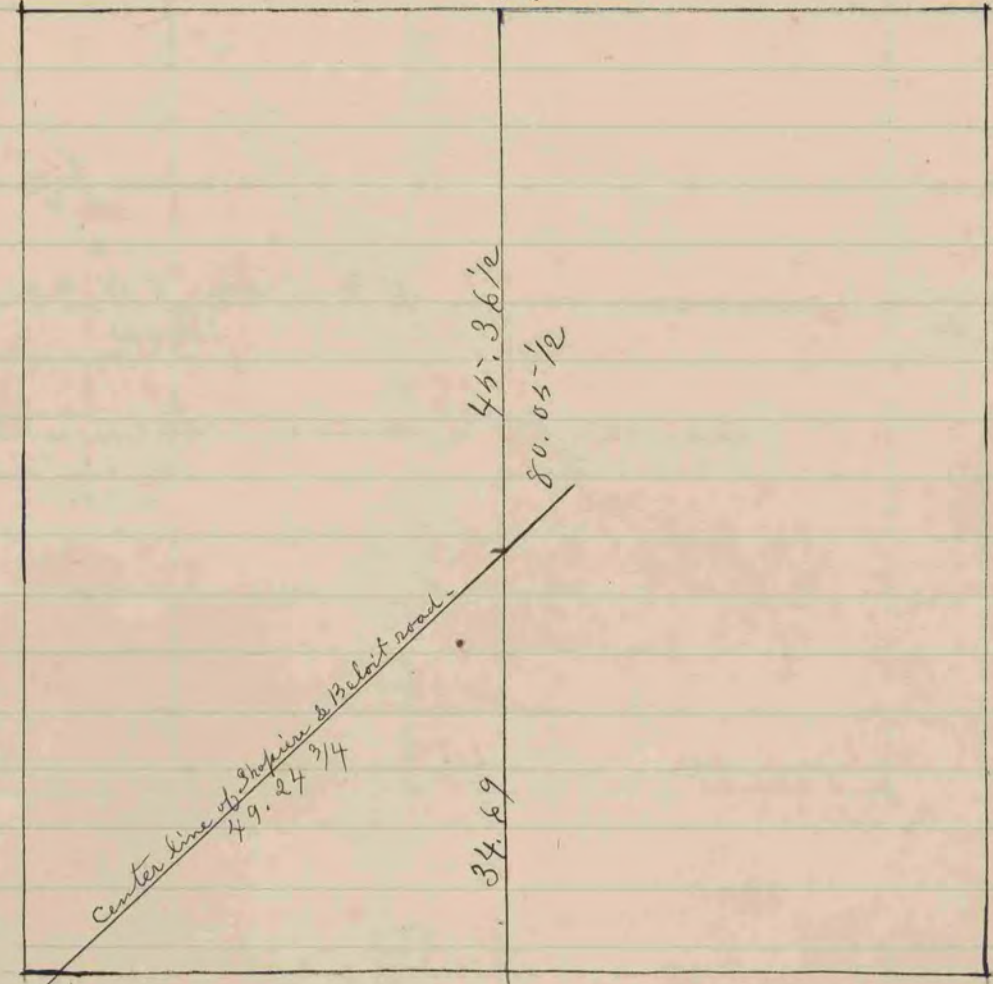

Set limestone irregular as
pointed 30x8x8 print up

(See Page 71 of Vol 22)

The above is a record & plat of a survey made
by me on Sec. 19 Turtle, Oct. 5th 1887.