


COUNTY SURVEYOR
RECORD 1859-1906

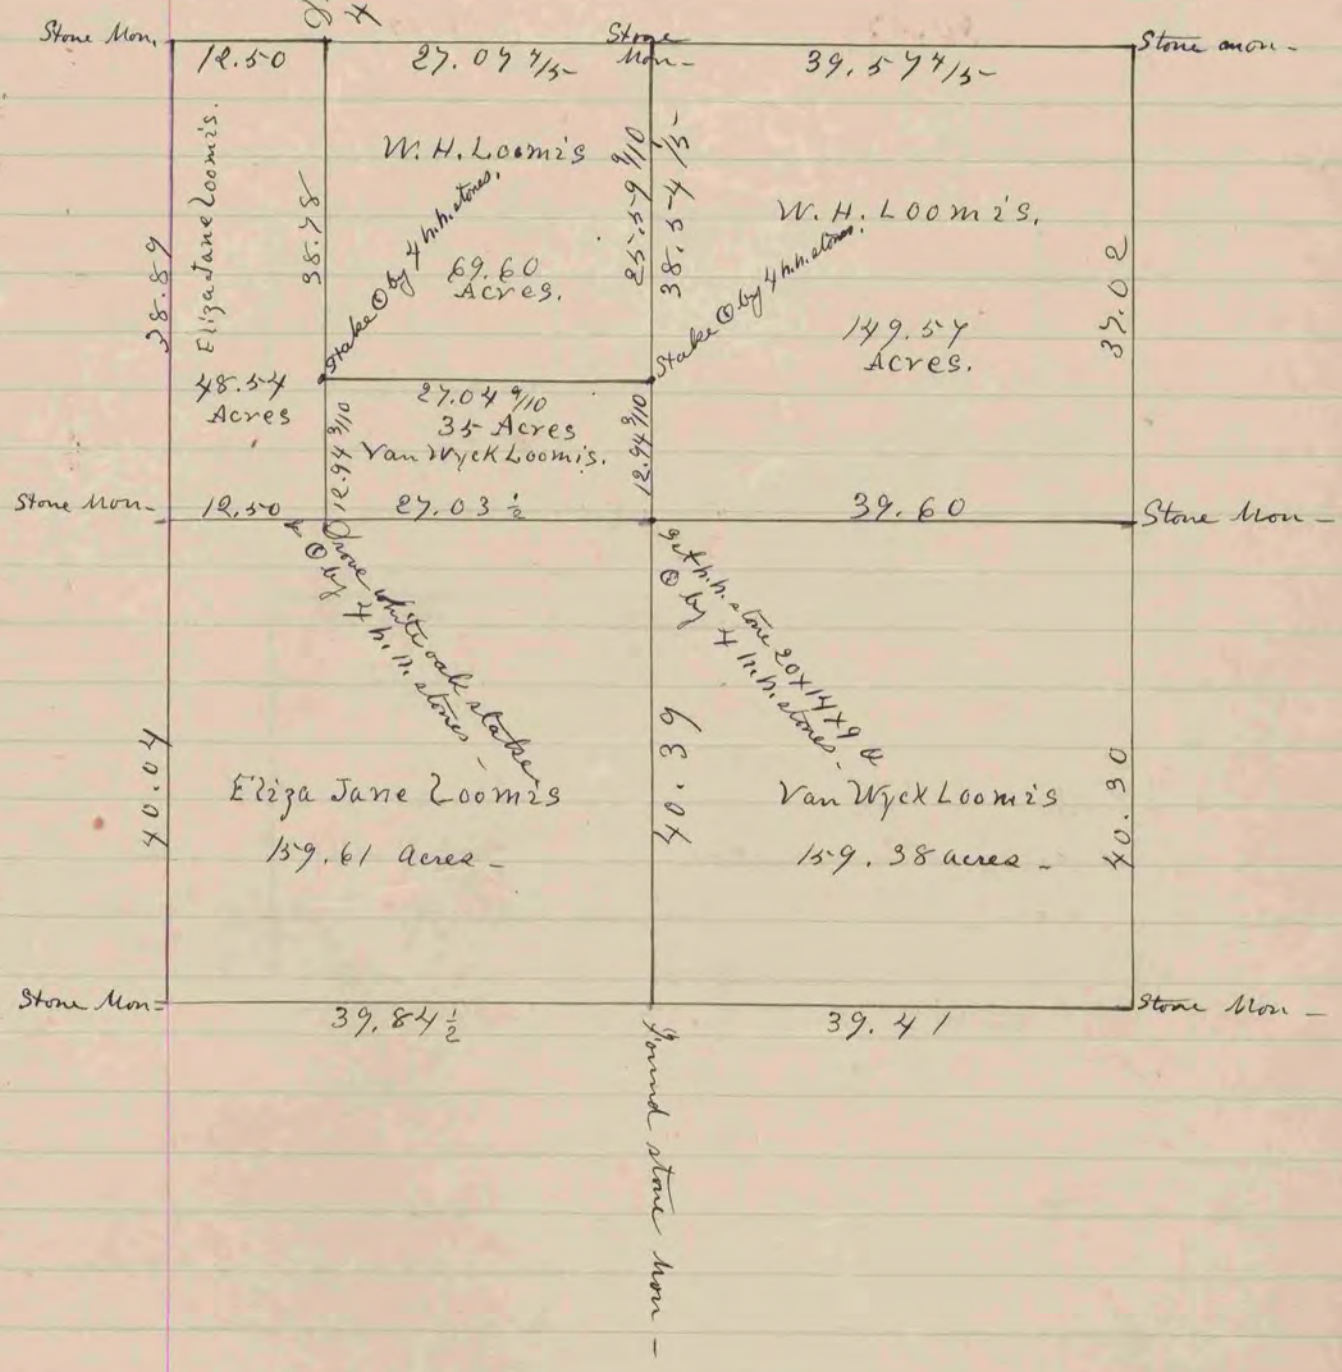

The above is a record & plat of a survey made by me on Sec. 2 Union April 29th 1884