


Rec Vol 2
Pg 363

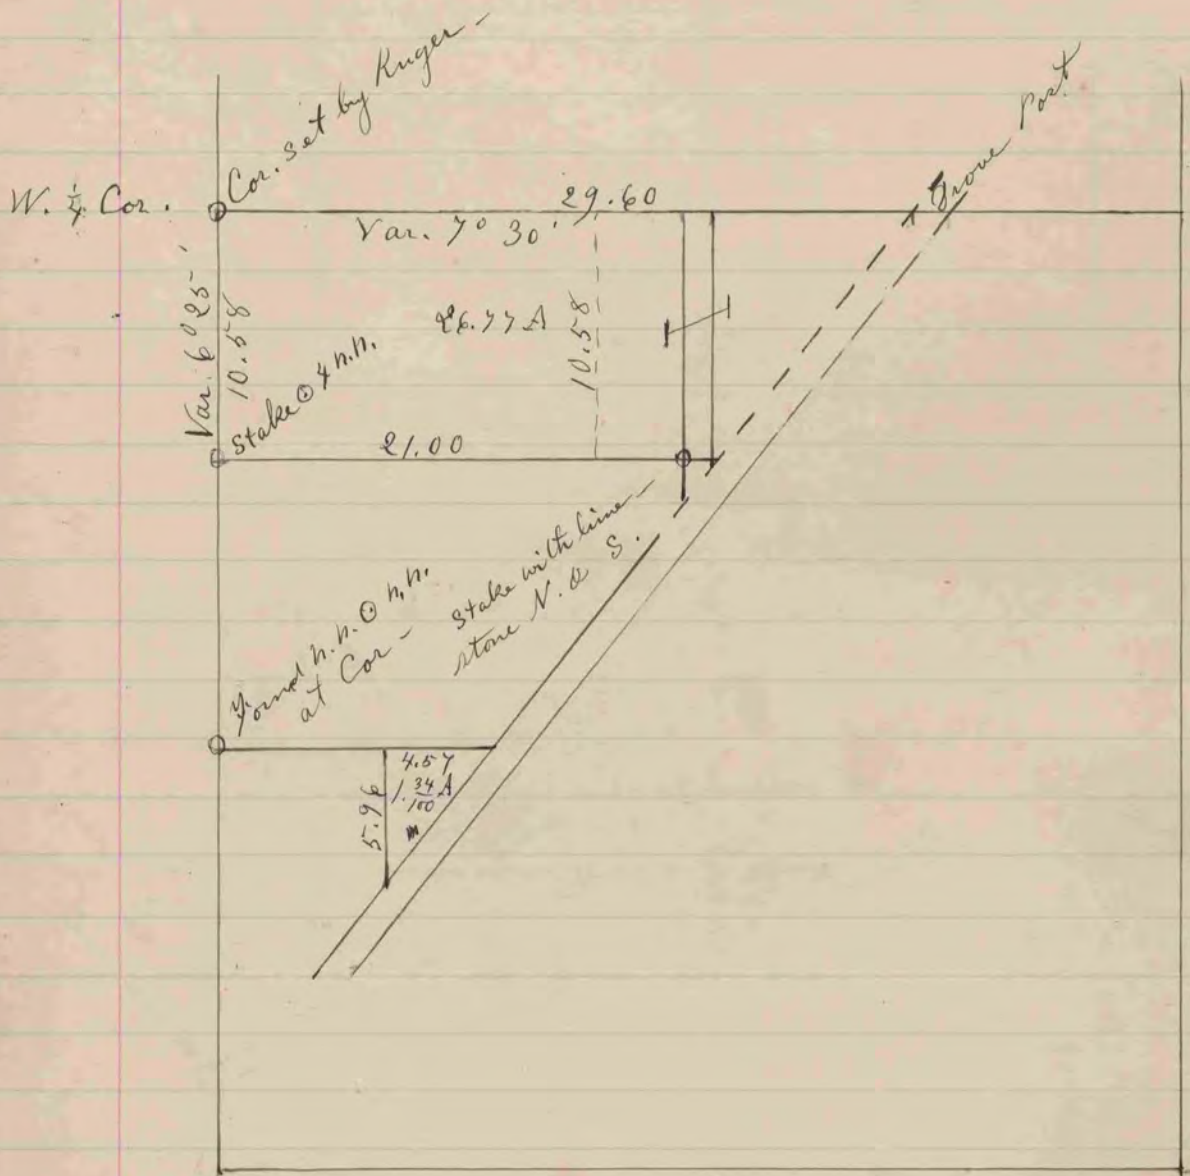

The above is a record & plat of a Survey
made by me Nov. 23^d & 24th 1883 on Sec. 16.
Tulton.

R. K. Lee Dept. Co. Surveyor -