


The above is a record & plat of a Survey made by me on the S.W. 1/4 of Sec. 4 Fulton May 29<sup>th</sup> 1883

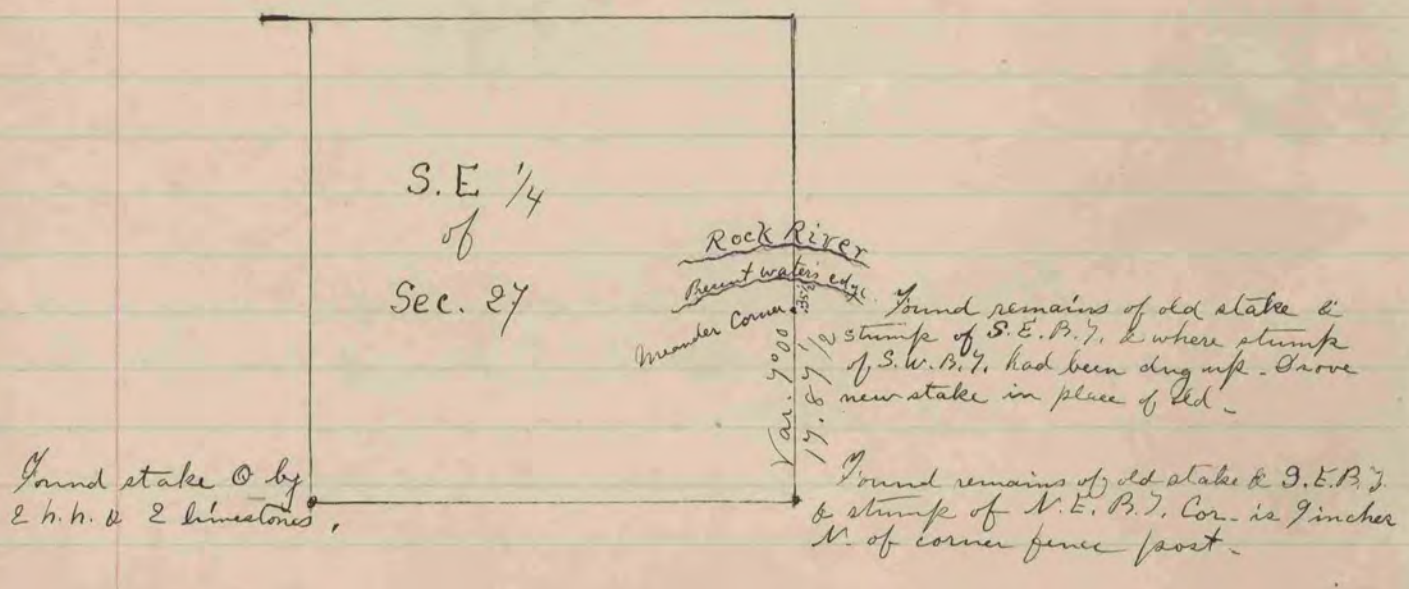

The above is a record & plat of a Survey made by me on the S.E. 1/4 of Sec. 27 Rock. Mar. 21 - 1887