


Found stake & stone
set by self - east in place
of stake - sandstone 18x12
x 8 & put h.h. stone on N &
S. sides

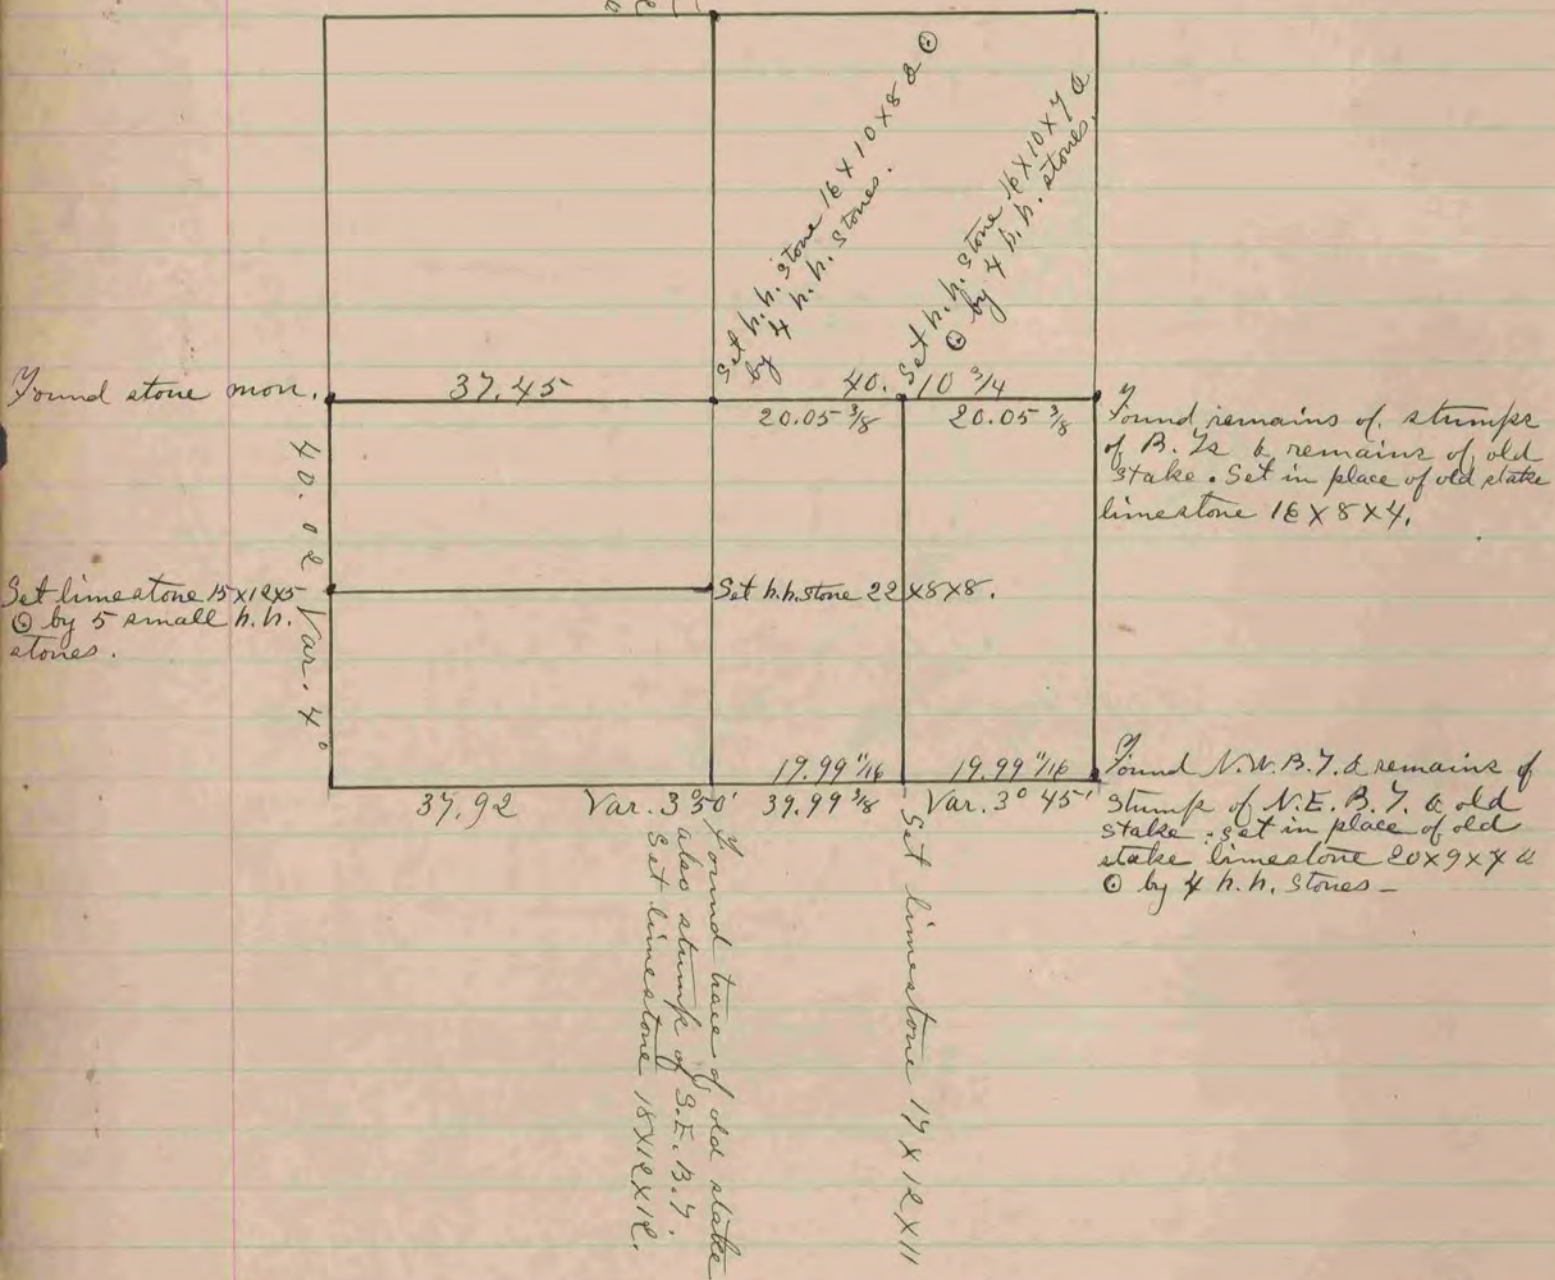

The above is a record & plat of a survey made by me on Sec. 31 Lima. Sept. 8th 1884