


The above is a record & plat of a Survey made by me June 20<sup>th</sup> & 21<sup>st</sup> 1882 - on Sec. 33 Bradford to part off approximately 52 acres from the W. side of the N.W. 1/4 of the Sec.

R. K. Lee - Dept. Co. Surveyor -

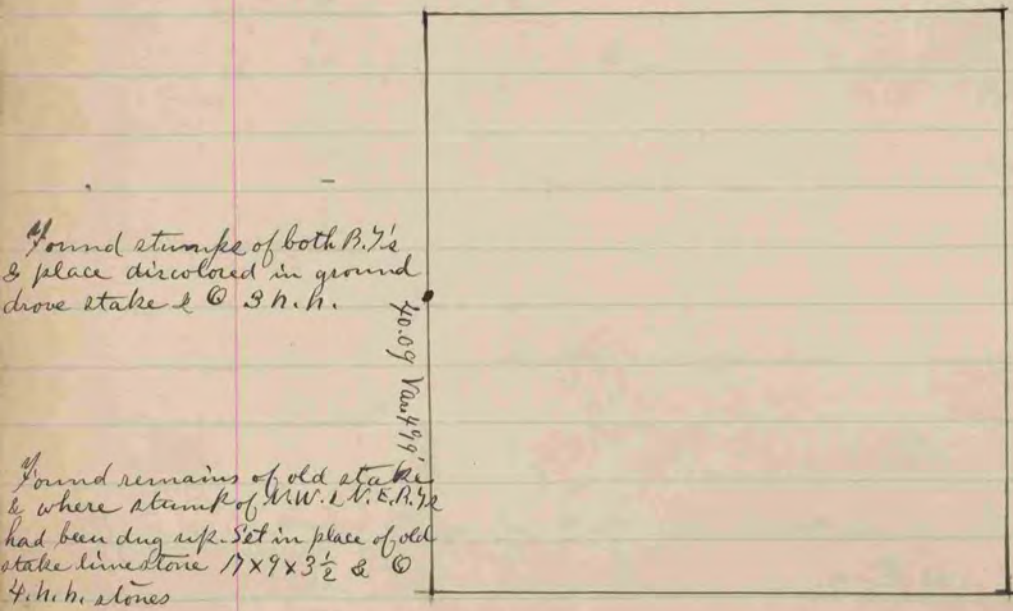

The above is a record & plat of a survey made by me on Sec. 34 Clinton Sept. 26<sup>th</sup> 1884