

U.S. PUBLIC LAND SURVEY MONUMENT RECORD

For Public Land Survey Corners in:

WI ADMINISTRATIVE CODE A-E 7.08 REQUIREMENT

T. 1N., R. 11E

CORNER CODE INDEX

A	1	2	3	4	5	6	7	8	9	10	11	12	13	14	15	16	17	18	19	20	21	22	23	24	25
B	6																								
C		5																							
D																									
E																									
F	1	2	3	4	5	6	7	8	9	10	11	12	13	14	15	16	17	18	19	20	21	22	23	24	25
G		◆	8																						
H																									
I																									
J	18	17	16	15	14	13	12	11	10	9	8	7	6	5	4	3	2	1							
K																									
L																									
M																									
N																									
O																									
P	19	20	21	22	23	24	25	26	27	28	29	30	31	32	33	34	35	36							
Q																									
R																									
S																									
T	30	29	28	27	26	25	24	23	22	21	20	19	18	17	16	15	14	13	12	11	10	9	8	7	6
U																									
V																									
W																									
X	31	32	33	34	35	36																			
Y																									
Z																									

NEWARK TWP
ROCK COUNTY WI

IF AVAILABLE
ROCK COUNTY COORDINATES PREFERRED

North _____ Elev. _____

East _____

Hor. Datum _____ Vert. Datum _____

LATITUDE _____ ELLIPS. HT. _____

LONGITUDE _____

GPS (X) _____ TRAVERSE (X) _____

BASED ON THE FOLLOWING CONTROL:

PLACE MONUMENT SYMBOL **◆** AT PROPER LOCATION ON ABOVE INDEX

◆ CORNER MONUMENT **○** WITNESS MONUMENT

(a)

BEARINGS ARE BASED ON:

Fd TIES IN JOLAPG 460

OBSERVATION Sheet 535

FIELD BOOK _____ PAGE # _____

SHEET 1 OF 1

SHOW A PLAN VIEW DRAWING DEPICTING THE CORNER MONUMENT AND SURROUNDING PHYSICAL FEATURES, INCLUDING THE EXCAVATION AREA AND DEPTH.

PLANNING & ZONING COMMITTEE ADOPTED THE ABOVE FORM ON 12/2/1982

CORNER CODE G-5

NE535

(B) Describe any record evidence, monument evidence, occupational evidence, testimonial evidence or any other material evidence you considered, and whether the monument was found or placed.

- 1834 MILLER PG 36 NORTH BETWEEN SECS 7 & 8
 - 1125.3 BUR OAK 16 IN DIA
 - 2139.72 YELLOW OAK 6 IN
 - 2640 SET 1/4 SEC POST YELLOW OAK 14 IN N12E 9.9'; YELLOW OAK 10 IN S70W 64.68'
 - 4123.68 BUR OAK 5 IN DIA
 - 5280 SET POST COR SECS 5,6,7,8 BUR OAK 10 IN S15W 24.42'; BUR OAK 10 IN N74E 85.8'
- 1871 COLLINS REMONUMENTATION PG 195 NORTH BETWEEN 7 & 8 VARIATION 6-50
 - 2652.54 SET 1/4 STONE BY STUMPS OF WITNESS TREES CONTINUED NORTH
 - 5316.96 INTERSECT SECTION LINE 18.48' EAST OF CORNER SET STONE FOR 5,6,7,8 BY WITNESS TREES. CORRECTED VARIATION 5-50
 - REMON. MAP 2652.54' VAR 6-50 TO SE COR SEC 7 & 2664.42 VAR 5-50 TO NE COR S SEC 7.
- 1937 SUNNY VOL 3 PG 357 DUG 10'X16'X3.5' DEEP. FOUND NO MON. 2664.4 TO NE COR SEC 7.
- 1970 BATTERMAN VOL 4 PG 460 FD PK NAIL OVER PATCH IN RD AT E 1/4 COR SEC 7-1-11. NOT CERTAIN TO BE OVER COR. JULY 1969. REFERENCED SAME.
- 1977 LEUENBERGER CSM VOL 7 PG 107 1326.27 FROM SW COR SEC 8 TO THE W 1/16TH COR OF THE SW 1/4 OF SEC 8.
- 1981 TOWNSEND CSM 10 PG 357 2646.86 TO CENTER OF SEC 8.
- 1981 TOWNSEND #13198 2658.92 TO NW COR SEC 8, 2646.86 TO CENTER OF SEC 8, & ANGLE OF 89-33-50 @ CENTER OF SEC 8 FROM W 1/4 COR TO N 1/4 CORNERS OF SEC 8.
- 1994 LEUENBERGER #9509 1326.27 FROM SW COR SEC 8 TO THE W 1/16TH COR OF THE SW 1/4 OF SEC 8 & ANGLE OF 90-26-23 @ SW COR SEC 8 FROM THE W 1/4 COR SEC 8 TO THE S 1/4 COR SEC 8.

FD C.I. MON @ N/S CENTER PVMT., 1' SOUTH OF N/S PVMT EDGE PROJECTED FROM WEST, 3' NORTH OF CENTER OF PVMT PROJECTED FROM EAST. PVMT IS A HIGHER ELEVATION THAN THE SURROUNDING TERRAIN.

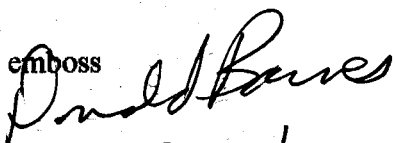
C) Was the corner restored through acceptance of (1) an obliterated evidence location, or, (2) a found perpetuated location?

ACCEPTED FOUND CAST IRON MON.

D) Describe any material discrepancy between the location of the corner as restored or reestablished and the location of that corner as previously restored or reestablished by distance and direction. Show the discrepancy on the plan view drawing under (a), above. Show the distances between the corner as previously restored or reestablished and (1) the corner as restored or reestablished, and (2) to at least 4 of the witness monuments shown on the drawing in (a), above.

I, Donald Barnes, hereby certify that the corner location as identified by the corner code index was determined by me under my direction and control and that this U.S. Public Land Survey Monument Record is correct and complete to the best of my knowledge and belief.

seal

emboss

 b-29-01

Number of included sheets 1

CORNER CODE G-5

A-E 7.08 REQUIREMENT