ELLIPS. HT.

PUBLIC LAND U.S. MONUMENT


SUR RECORD

For Public Land Survey Corners in:

WI ADMINISTRATIVE CODE A-E 7.08 REQUIREMENT

T. __N., R. ____E

CORNER CODE INDEX

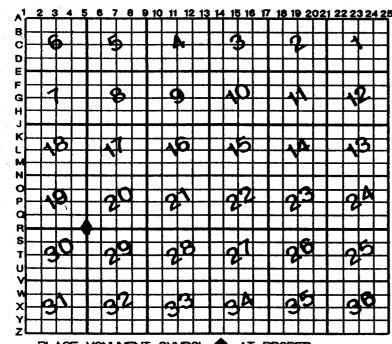

NEWARK ROCK COUNTY WI

IF AVAILABLE ROCK COUNTY COORDINATES PERFERRED

North Elev.

Hor. Datum _____ Vert. Datum

LONGITUTE

LATITUDE _____

GPS (X) ___ TRAVERSE (X) BASED ON THE FOLLOWING CONTROL:

CORNER MONUMENT

O WITNESS MONUMENT

BEARINGS ARE BASED ON:

(a)

OBSERVATION	SHEET 583
FIELD BOOKPAGE	#
SHOW A PLAN VIEW DRAWIN	IG DEPICTING THE COF
DINGIOLI ESTETUTE MOLLIS	NO THE EVOLUTION

SHEET

RNER MONUMENT AND SURROUNDING FEATURES, INCLUDING THE EXCAVATION AREA AND DEPTH. PLANNING & ZONING COMMITTEE ADOPTED THE ABOVE FORM ON 12/2/1982

NE583

(B)Describe any record evidence, monument evidence, occupational evidence, testimonial evidence or any other material evidence you considered, and whether the monument was found or placed.

1834 MILLER (MARCH)

PG 33

WEST RANDOM BETWEEN SECS 19 & 30

5243.7 INTERSECT RANGE LINE 36.96' SOUTH POST LAND GENTLY ROLLING 2ND RATE TIMBER OAK & HICKORY OAK & HAZEL U.G. (UNDER GROWTH)

EAST CORRECTED BETWEEN SEC 19 & 30

SET POST COR OF 19 & 30 BUR OAK 14 IN S27E 32.34'; BUR OAK 14 IN N37E 79.86

87.12 BUR OAK 15 IN DIA

792 WHITE OAK 15 IN DIA

2593.8 BUR OAK 12 IN DIA

2603.7 SET 1/4 SEC POST BUR OAK N73E 9.9'; BUR OAK 16 S29W 15.18'

2947.56 BUR OAK 18 IN

4979.7 BUR OAK 10 IN

5243.7 SEC COR

PG 33

NORTH BETWEEN SECS 19 & 20

706.2 BUR OAK 14 IN

2425.5 WHITE OAK 22 IN

2640 SET 1/4 SEC POST YELLOW OAK 15 S43W 34.32'; WHITE OAK 24 N43E 69.3'

3689.4 BUR OAK 18 IN DIA

5103.12 YELLOW OAK 22 IN DIA

5280 SET POST COR SECS 17,18,19,20 YELLOW OAK 10 N78E 100.32';
BUR OAK 20 S44W 69.3' LAND GENTLY ROLLING 2ND RATE
TIMBER OAK & HICKORY OAK & HAZEL U.G. PRAIRIE GRASS TO
PG 32 NORTH BETWEEN SECS 29 & 30

1478.4 BUR OAK 12

2640 SET 1/4 SEC POST BUR OAK 20 S58E 23.1'; BUR OAK 12 N81W 8.58'

4099.92 YELLOW 5 IN DIA

5280 SET POST CORNER 19,20,29,30 WHITE 22 N67W 67.98, YELLOW OAK 6 S88-30E 47.52' LAND GENTLY ROLLING 2ND RATE SOIL SANDY TIMBER OAK & HICKORY

PG 32 EAST RANDOM BETWEEN SECS 20 & 29

5334.78 INTERSECT SEC LINE AT POST LAND SAME

WEST MARKED BACK

339.9 BUR OAK 24 IN DIA

1402.98 BUR OAK 12 IN DIA

2086.26 BUR OAK 12 IN DIA

2667.72 SET 1/4 SEC POST YELLOW OAK 24 N20W 25.74'; WHITE OAK 18 S62W 89.76'

5334.78 SEC COR

1851 MCVEAN VOL 1 PG 6 STATES NOTHING ABOUT MON. 2674.32 TO S 1/4 COR SEC 20 & 2640 TO W 1/4 COR SEC 20

1870 RUGER VOL 2 PG 42 FD STUMPS OF BOTH BEARING TREES. SET SANDSTONE 27X10X9 & SURROUNDED IT WITH 4 L.S. VAR 5-15 2646.6 TO S1/4 COR SEC 19 VAR 5-42 2653.86 TO E 1/4 COR SEC 19

1871 COLLIN'S REMONUMENTATION NOTES

PG 202

EAST BETWEEN 19 & 30 VARIATION 5-20

2608.98 SET 1/4 STONE IN PLACE OF STONE SET BY RUGER AGREEING WITH WITNESS TREE.

CONTINUED EAST VARIATION 4-30

5254.26 SECTION CORNER

PG 190 NORTH BETWEEN 19 & 20 VARIATION 5-20*

2657.82 INTERSECT 1/4 LINE 3.3' WEST OF CORNER SET 1/4 STONE IN PLACE OF STAKE SET BY RUGER AGREEING WITH STUMP OF WITNESS TREES. CORRECTED VARIATION 5-25

SHEET 1 OF 2

R-5

7-02-01

CONTINUED NORTH VARIATION 5-30

5315.64 INTERSECT SECTION LINE 9.24' WEST OF CORNER SET STONE FOR CORNER OF 17,18,19,20 IN PLACE OF STONE SET BY RUGER AGREEING WITH ROOTS OF WITNESS TREES. CORRECTED VARIATION 5-42

PG 189 WEST BETWEEN 20 & 29 VARIATION 9

2689.5 INTERSECT 1/4 LINE 66' SOUTH OF CORNER. SET 1/4 STONE BY STUMP OF WITNESS TREE CORRECTED VARIATION 7-33

CONTINUED WEST ON OFFSET 41.58' NORTH VARIATION 10

5377.02 INTERSECT SECTION LINE 69.3' SOUTH OF CORNER CORRECTED VARIATION 7-35

PG 188 NORTH BETWEEN 29 & 30 VARIATION 7-27

- 2659.8 SET 1/4 STONE BY STUMPS OF WITNESS TREES. CONTINUED NORTH VARIATION 7-30
- 5320.92 SET STONE FOR CORNER OF 19,20,29,30 IN PLACE OF STONE SET BY RUGER. AGREEING WITH WITNESS TREE AND STUMP. OCT 30 1871
- 1931 SUNNY VOL 3 PG 191 FD 6X9 CUT STONE BROKEN OFF. 229.2 SOUTH OF REFERENCED POINT. ON LINE WITH E/W FENCE ON NORTH SIDE OF DIRT RD TO THE WEST.
- 1953 BATTERMAN BK 16 PG 2 (SUBDIVISION PLATS) 2652.0 TO S 1/4 COR SEC 19.
- 1975 SCHROEDER VOL 5 PG 81 SET 1" IRON PIPE OVER STONE MON. & REFERENCED SAME.
- 1975 SHIMEALL #6332 1319.67 FROM W 1/4 COR SEC 29 NORTH TO W 1/16TH COR OF NW 1/4 SEC 29
- 1977 COMBS CSM 7 PG 100 ANGLE OF 92-48-20 @ NE COR SEC 30 FROM E 1/4 TO N 1/4 CORNERS SEC 30.
- 1995 KREBS #9255 1319.57 FROM W 1/4 COR SEC 29 NORTH TO W 1/16TH COR OF NW 1/4 SEC 29
- 1996 KREBS CSM 19 PG 67 2685.58 TO S 1/4 COR SEC 20

FD 1 1/4" PIPE 0.15' DEEP. 3.4' WEST OF CENTER OF PVMT & 3 NORTH OF CENTER OF PVMT. PROJECTED FROM WEST.

C) Was the corner restored through acceptance of (1) an obliterated evidence location, or, (2) a found perpetuated location?

ACCEPTED FD PERPETUATED LOCATION.

ld Baines

- D) Describe any material discrepancy between the location of the corner as restored or reestablished and the location of that corner as previously restored or reestablished by distance and direction. Show the discrepancy on the plan view drawing under (a), above. Show the distances between the corner as previously restored or reestablished and (1) the corner as restored or reestablished, and (2) to at least 4 of the witness monuments shown on the drawing in (a), above.
- (E) Was the corner reestablished through lost corner proportionate methods? If so, show the method, including the directions and distances to other public land survey corners used as evidence or used for proportioning the corner location.
- I, Donald Barnes, hereby certify that the corner location as identified by the corner code index was determined by me under my direction and control and that this U.S. Public Land Survey Monument Record is correct and complete to the best of my knowledge and belief.

seul

Esodin

SHEET 2 OF 2

7-2-01

CORNER CODE R-5

A-E 7.08 REQUIREMENT