U.S.


LAND **PUBLIC** SURVEY MONUMENT RECORD

For Public Land Survey Corners in:

WI ADMINISTRATIVE CODE A-E 7.08 REQUIREMENT

N. T. ____N., R. _____E

CORNER CODE INDEX

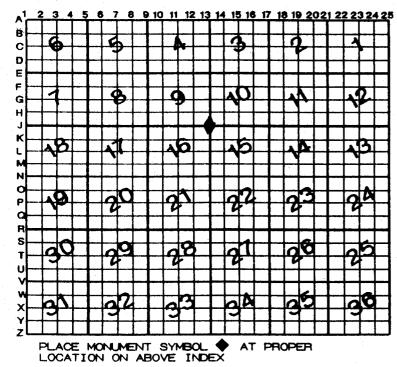

NEWARK ROCK COUNTY WI

IF AVAILABLE ROCK COUNTY COORDINATES PERFERRED

North Elev.

East

Hor. Datum _____ Vert. Datum .

LONGITUTE

__ ELLIPS. HT.

GPS (X) ___ TRAVERSE (X)

BASED ON THE FOLLOWING CONTROL:

♦ CORNER MONUMENT

O WITNESS MONUMENT

LATITUDE

(a)

FOUND TIES AS SHOWN IN VOLAPG 219

BEARINGS ARE BASED

				CI	HEET C	2
FIELD	BOOK	PAGE #	<u> </u>	Sr.	1001	<i>JF</i>
SHOW	A PLAN VIEW	DRAWING DEPICTING	THE CORNER M	ONUMENT AND S	SURROUNDING	
PHYSIC	CAL FEATURES.	INCLUDING THE EXC	AVATION AREA	AND DEPTH.		

PLANNING & ZONING COMMITTEE ADOPTED THE ABOVE FORM ON 12/2/1982

NE547

(B)Describe any record evidence, monument evidence, occupational evidence, testimonial evidence or any other material evidence you considered, and whether the monument was found or placed.

1834 MILLER

PG 28

EAST RANDOM BETWEEN 9 & 16

264 ENTER MARSH

5246.34 INTERSECT 1.32' NORTH OF POST LAND GENTLY ROLLING 2ND RATE TIMBER OAK & HICKORY OAK & HAZEL U.G.

WEST CORRECTED BETWEEN SEC 9 & 16

2065.14 BUR OAK 12 DIA

2621.52 SET 1/4 SEC POST BUR OAK 12 IN S13W 26.4'; BUR OAK 12 IN N32W 31.68'

4210.14 BUR OAK 12 IN

5246.34 SEC COR

PG 23

NORTH BETWEEN 9 & 10

2030.16 HICKORY 12 IN

2244 ENTER PRAIRIE

2640 SET 1/4 SEC POST. YELLOW OAK 15 IN S13W 429'; YELLOW OAK 15 IN S4E (4.69' OR 468.6' ?)

5280 SET POST IN MOUND OF EARTH AND SOD COR OF SEC 3,4,9, 10 LAND 2ND RATE SOUTH 1/2 LEVEL TIMBERED WITH OAK & HICKORY OAK & HAZEL . NORTH HALF ROLLING PRAIRIE.

PG 23

EAST RANDOM BETWEEN SECS 10 & 15

4950 ENTER PRAIRIE

5303.1 INTERSECT SEC LINE 4.62' NORTH POST

2651.22 SET 1/4 SEC POST BUR OAK 12 S9W 72.6'; WHITE OAK 14 N56W 86.46'

3290.76 WHITE OAK 18 IN DIAMETER

5303.1 SEC CORNER LAND GENTLY ROLLING 2ND RATE, TIMBER OAK & HICKORY

PG 22

NORTH BETWEEN 15 & 16

1013.76 BUR OAK 8 IN

2271.72 YELLOW OAK 14 IN

2640 SET 1/4 SEC POST BUR OAK 5 IN S89E 4.62'; BUR OAK 8 IN N35W 7.92'

3148.2 BUR OAK 20 IN DIA

3639.24 BUR OAK 14 IN DIA

5280 SET POST COR OF SECS 9,10,15,16 BUR OAK 18 N71W 58.08'; WHITE OAK 20 S75E (103.62' OR 499.62?)

1871 COLLINS REMONUMENTATION NOTES

PG 182 EAST BETWEEN 9 & 16 VARIATION 5

2640 SET 1/4 STONE BY STUMP OF WITNESS TREE.

CONTINUED EAST VARIATION 4-50

5274.06 SECTION CORNER

PG 170

NORTH BETWEEN 9 & 10 VARIATION 5-57

2677.62 SET 1/4 STONE IN PLACE OF STAKE SET BY MESSER SAID BY SHOEMAKER TO HAVE BEEN THERE 20 YEARS

CONTINUED NORTH VARIATION 5-30

5344.68 SET STONE FOR CORNER OF 3,4,9,10 IN INTERSECTION OF HIGHWAY. PG 169 WEST BETWEEN 10 & 15 VARIATION 3

2659.14 SET 1/4 STONE (UNDER BRIDGE) BY WITNESS TREE

CONTINUED WEST SAME VARIATION

5345.34 SECTION CORNER

PG 168

NORTH BETWEEN 15 & 16 VARIATION 5-30

2655.18 INTERSECT 1/4 LINE 8.58' EAST OF CORNER. SET 1/4 STONE BY WITNESS TREE CORRECTED VARIATION 5-18

CONTINUED NORTH VARIATION 5

5317.62 INTERSECT SECTION LINE 21.12' EAST OF CORNER SET STONE FOR CORNER OF 9, 10, 15, 16 BY STUMP AND ROOTS OF WITNESS TREE.

CORRECTED VARIATION 4-27 OCT 24, 1871

SHEET 1 OF 2 J-13

Donal Bornes 6-28-07

- 1958 LEE CSM 4 PG 149 2668.50 TO N 1/4 COR SEC 15
- 1965 BATTERMAN VOL 4 PG 219 FD CUT STONE MON. & REFERENCED SAME.
- 1973 LEE CSM 3 PG 163 ANGLE OF 86-40-15 @ S 1/4 COR SEC 10 FROM SW TO N 1/4 CORNERS OF SEC 10
- 1976 BARNES VOL 5 PG 144 2660.69 TO E 1/4 COR SEC 16.
- 1996 LEUENBERGER CSM 19 PG 393 2668.50 TO N 1/4 COR SEC 15 & 1338.26 TO W 1/16TH COR OF SW 1/4 SEC 10

FD R/R WITH DRILL HOLE. 1' NORTH OF CENTER PVMT; 3' WEST OF CENTER PVMT. TO SOUTH; ON LINE CENTER PVMT TO NORTH.

C) Was the corner restored through acceptance of (1) an obliterated evidence location, or, (2) a found perpetuated location?

ACCEPTED FOUND MON. IN HARMONY WITH RECORD DISTANCES.

- D) Describe any material discrepancy between the location of the corner as restored or reestablished and the location of that corner as previously restored or reestablished by distance and direction. Show the discrepancy on the plan view drawing under (a), above. Show the distances between the corner as previously restored or reestablished and (1) the corner as restored or reestablished, and (2) to at least 4 of the witness monuments shown on the drawing in (a), above.
- (E) Was the corner reestablished through lost corner proportionate methods? If so, show the method, including the directions and distances to other public land survey corners used as evidence or used for proportioning the corner location.

I, Donald Barnes, hereby certify that the corner location as identified by the corner code index was determined by me under my direction and control and that this U.S. Public Land Survey Monument Record is correct and complete to the best of my knowledge and belief.

أرهه

6-28-01

SHEET 2 OF 2

CORNER CODE J-13

A-E 7.08 REQUIREMENT