

# U.S. PUBLIC LAND SURVEY MONUMENT RECORD

For Public Land Survey Corners in:

WI ADMINISTRATIVE CODE A-E 7.08 REQUIREMENT

T. 1N., R. 11E

### CORNER CODE INDEX

1	2	3	4	5	6	7	8	9	10	11	12	13	14	15	16	17	18	19	20	21	22	23	24	25
A																								
B																								
C	6																							
D																								
E																								
F																								
G	1																							
H																								
J																								
K																								
L	18																							
M																								
N																								
O																								
P	19																							
Q																								
R																								
S																								
T	30																							
U																								
V																								
W																								
X	31																							
Y																								
Z																								

NEWARK TWP

ROCK COUNTY WI

IF AVAILABLE  
ROCK COUNTY COORDINATES PREFERRED

North \_\_\_\_\_ Elev. \_\_\_\_\_

East \_\_\_\_\_

Hor. Datum \_\_\_\_\_ Vert. Datum \_\_\_\_\_

LATITUDE \_\_\_\_\_ ELLIPS. HT. \_\_\_\_\_

LONGITUDE \_\_\_\_\_

GPS (X) \_\_\_\_\_ TRAVERSE (X) \_\_\_\_\_

BASED ON THE FOLLOWING CONTROL:

PLACE MONUMENT SYMBOL  AT PROPER LOCATION ON ABOVE INDEX

CORNER MONUMENT

WITNESS MONUMENT

(a)

BEARINGS ARE BASED ON:

*FD TIES IN VOL A PG 361*

FIELD BOOK \_\_\_\_\_ PAGE # \_\_\_\_\_

SHEET 1 OF 1

SHOW A PLAN VIEW DRAWING DEPICTING THE CORNER MONUMENT AND SURROUNDING PHYSICAL FEATURES, INCLUDING THE EXCAVATION AREA AND DEPTH.

PLANNING & ZONING COMMITTEE ADOPTED THE ABOVE FORM ON 12/2/1982

CORNER CODE 519

NE550

(B) Describe any record evidence, monument evidence, occupational evidence, testimonial evidence or any other material evidence you considered, and whether the monument was found or placed.

1834 MILLER PG 17 (EAST) RANDOM BETWEEN 11 & 14

5272.08 INTERSECTED SEC LINE 36.96 SOUTH OF POST  
LAND ROLLING 2ND RATE LINE RUNNING BORDER OF PRAIRIE  
TIMBER OAK & HICKORY

WEST CORR. BETWEEN SECS 11 & 14

2636.04 SET 1/4 SEC POST HICKORY 12 N18E 27.06'; BUR OAK 15 S47E 42.9

4158 YELLOW OAK 12 IN DIAMETER

5272.08 SEC COR.

1871 COLLINS REMONUMENTATION NOTES

PG 156 EAST BETWEEN 11 & 14 VARIATION 9

2644.62 SET 1/4 STONE BY ROOTS OF WITNESS TREES

CONTINUED EAST VAR 8-30

5282.64 SEC CORNER. OCT 20 1871

1881 LEE VOL 2 PG 329 FD MON. VAR 5-33 ALONG N/S 1/4 LINE SEC 14

1968 BATTERMAN VOL 4 PG 361 FD CUT STONE TIPPED OVER & BROKEN SET 2"

PIPE IN HOLE WHERE STONE WAS & PUT BROKEN PIECES AROUND PIPE.

REFERENCED SAME.

1980 TOWNSEND CSM 10 PG 212 2637.10 TO SE COR SEC 10

FD 2" PIPE 0.7' DEEP. SET 3/4X24" PIPE INSIDE 2" PIPE.

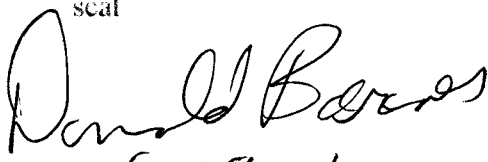
(C) Was the corner restored through acceptance of (1) an obliterated evidence location, or, (2) a found perpetuated location?

ACCEPTED FOUND 2" PIPE AS PERPETUATED LOCATION.

(D) Describe any material discrepancy between the location of the corner as restored or reestablished and the location of that corner as previously restored or reestablished by distance and direction. Show the discrepancy on the plan view drawing under (a), above. Show the distances between the corner as previously restored or reestablished and (1) the corner as restored or reestablished, and (2) to at least 4 of the witness monuments shown on the drawing in (a), above.

(E) Was the corner reestablished through lost corner proportionate methods? If so, show the method, including the directions and distances to other public land survey corners used as evidence or used for proportioning the corner location.

I, Donald Barnes, hereby certify that the corner location as identified by the corner code index was determined by me under my direction and control and that this U.S. Public Land Survey Monument Record is correct and complete to the best of my knowledge and belief.

seal  
  
6-29-01  
emboss

Number of included sheets 1

CORNER CODE J-19

A-E 7.08 REQUIREMENT