
U.S. PUBLIC LAND SURVEY MONUMENT RECORD

For Public Land Survey Corners in the T. / N., R. / E.

CORNER CODE INDEX

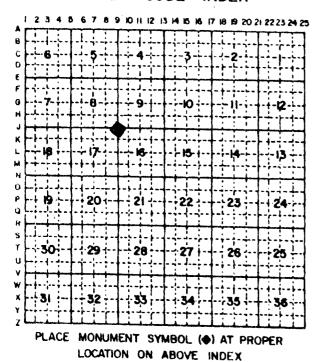

EXAMPLE

2 3 | Z-4 | NEWARK TWP

ROCK COUNTY W

CD-8/4

IF AVAILABLE STATE PLANE COORDINATES

North (Y)	Eleve. (2)
East (X)	Zone
Hor. Datum	Vert Datum

FUUND 1° PIPE S/02/2010 PM PLACED ALUM ON L.S FOUND CUT LIMESTONE e.) CORNER MONUMENT O WITNESS MONUMENT FOUND 1" PIPE REC 32,73 32,69' S84°26'10"W FOUND 3' PIPE 1.5' DEEP.
PLACED 2-7' ALUMINUM RISERS ON TOP N6*24'11"W BEARINGS ARE BASED ON : STATE PLANCE N14*01'20"W 61.58" EOPHAS RD \$8*17'51*E LARGE STUMP REC 22,55 575°41'41°W FD PIPE 8' ABOVE GROUND. DROVE PIPE TO GRADE

BK 2 PG 3 BK 4 PG 60

SHEET__ OF___/

CORNER CODE: 79

- (B) Describe any record evidence, monument evidence, occupational evidence, testimonial evidence or any other material evidence you considered, and whether the monument was found or placed.
- 1834 MILLER ORIGINAL GOVERNMENT SURVEY. PLACED POST WITH WITNESS TREES; BUR OAK 12IN S79E 366.96' AND YELLOW OAK 10 INCH N82-30E 288.42'
- 1871 COLLINS FIELD NOTES STATE THAT HE INTERSECTED SECTION LINE 9
 LINKS EAST OF CORNER. SET STONE FOR CORNER OF 8,9,16,17 BY
 STUMP OF WITNESS TREE. CALLS FOR A DISTANCE OF 2655.18' TO
 THE EAST QUARTER CORNER OF SECTION 17, AND 2651.88 TO THE
 NORTH QUARTER CORNER OF SECTION 17, 2640 TO THE NORTH
 QUARTER CORNER OF SECTION 16, AND 2652.54 TO THE EAST
 QUARTER CORNER OF SECTION 8. HIS MAP INDICATES THAT THE
 NORTH WEST CORNER. NORTH QUARTER CORNER, AND NORTH EAST
 CORNER OF SECTION 17 ARE ON A STRAIGHT LINE.
- CORNER OF SECTION 17 ARE ON A STRAIGHT LINE.

 1970 BATTERMAN JR. VOL 4 PG 460. PLACED 3" PIPE IN SOUTH EDGE OF ROAD 1' BELOW SURFACE. PIPE ON FENCE LINE EXTENDED. HE REFERENCED SAME.

PLACED 2 7" ALUMINUM EXTENSION MONUMENTS ON TOP OF 3" PIPE.

SEVERAL WEEKS LATER, I DUG WITH THE CRUZ AIR AND FOUND THE CUT LIMESTONE. THE STONE WAS SPLIT LENGTHWISE AND LEANING TO THE NORTH. THE STONE APPEARS TO HAVE BEEN DISTURBED. THIS POSITION IS IN HARMONY WITH LOCKE'S DISTANCES TO THE EAST, WEST, NORTH, AND SOUTH. Placed Alum on Stone, 5/02/2010 DATA

- C) Was the corner restored through acceptance of (1) an obliterated evidence location, or, (2) a found perpetuated location?
- D) Describe any material discrepancy between the location of the corner as restored or reestablished and the location of that corner as previously restored or reestablished by distance and direction. Show the discrepancy on the plan view drawing under (a), above. Show the distances between the corner as previously restored or reestablished and (1) the corner as restored or reestablished, and (2) to at least 4 of the witness monuments shown on the drawing in (a), above.

THE CORNER SHOULD BE EXCAVATED FOR AS SHOWN IN THE SKETCH.
I DID NOT ACCEPT THE FOUND 2" PIPE.

- (E) Was the corner reestablished through lost corner propertionate methods? If so, show the method, including the directions and distances to other public land survey corners used as evidence or used for proportioning the corner location.
- I, Donald Barnes, hereby certify that the corner points as identified by the corner code index were, in a field survey on, October 13,1989, cstablished, re-established, monumented, re-monumented, recovered or restored as expressed below and in conformance with the regulations and rules as required in the current manual of survey instructions of the United States Department of Interior, Bureau of Land Management.

Date of computer entry

Date microfilmed

Number of included sheets

CORNER CODE

AFFIN YOUR LAND SURVEYOR SEAL