
U.S. PUBLIC LAND SURVEY MONUMENT RECORD

For Public Land Survey Corners in:

WI ADMINISTRATIVE CODE A-E 7.08 REQUIREMENT

T.____N., R.____/_E

CORNER CODE INDEX

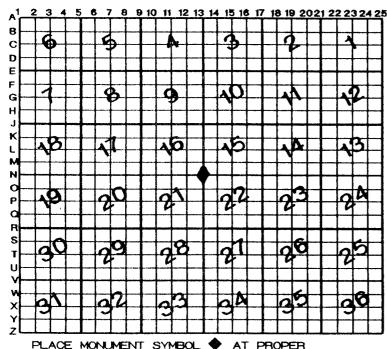

NEU	JARK	TWJ
ROCK	COUNTY	WI

IF AVAILABLE
ROCK COUNTY COORDINATES PERFERRED

North	Elev.
East	
Hor. Datum	Vert. Datum
LATITUDE	ELLIPS. H
LONGITUTE	
GPS (X)	TRAVERSE (X)
BASED ON THE	FOLLOWING CONTROL:

♦CORNER MONUMENT

LOCATION ON ABOVE INDEX

O WITNESS MONUMENT

BEARINGS ARE BASED ON:

(a)

ORCERIL	a To	Sheet	718
 DPSE100	~ (CON	Sueet	2/0

SHEET ____ OF _

SHEET ______
SHOW A PLAN VIEW DRAWING DEPICTING THE CORNER MONUMENT AND SURROUNDING PHYSICAL FEATURES, INCLUDING THE EXCAVATION AREA AND DEPTH.

PLANNING & ZONING COMMITTEE ADOPTED THE ABOVE FORM ON 12/2/1982

NE567

(B)Describe any record evidence, monument evidence, occupational evidence, testimonial evidence or any other material evidence you considered, and whether the monument was found or placed.

1834 MILLER

PG 21 NORTH BETWEEN SECS 21 & 22

- 782.1 BUR OAK 18 IN DIAMETER
- 1797.84 SPRING BROOK C S.E. 1.32' WIDE
- 2241.36 BUR OAK 20 IN
- 2640 SET 1/4 SEC. POST BUR OAK 20 IN S24E 29.7'; BUR OAK 20 IN N82W 14.52'
- 2772 ENTER MARSH C S.E.
- 3305.28 BROOK 1.32' S.W
- 4422 LEAVE MARSH
- 4923.6 BUR OAK 20 IN
- 5280 SET POST COR OF SEC 14,15,21,22 BUR OAK 16 S49E 31.68'; BUR OAK 20 N51W 38.94. LAND MOSTLY 2ND RATE LEVEL

PG 27 EAST RANDOM BETWEEN SECS 16 & 21

- 211.2 CREEK S 6.6'
- 858 LEAVE CREEK BOTTOM
- 3696 MARSH (CIRCULAR)
- 4620 LEAVE SAME
- 5264.82 INTERSECT SEC LINE 5.94' SOUTH OF POST LAND GENTLY ROLLING 2ND RATE TIMBER OAK & HICKORY OAK & HAZEL (UNDER GROWTH)

WEST CORRECTED BETWEEN SECS 16 & 21

- 2632.08 SET 1/4 SEC POST BUR OAK 16 N6W 31.68; BUR OAK 12 S77E 40.26'
- 2921.82 YELLOW OAK 14 IN DIA
- 3806.22 BUR OAK 15 IN DIA
- 5264.82 SEC COR

PG 22 EAST RANDOM BETWEEN SEC 15 & 22

- 1782 ENTER MARSH SOUTH
- 2244 LEAVE SAME
- 5315.64 INTERSECT SEC LINE 19.14' NORTH OF POST LAND 2ND RATE GENTLY ROLLING TIMBER OAK & HICKORY OAK & HAZEL (UNDER GROWTH)

WEST CORRECTED BETWEEN SECS 22 & 15

- 2657.82 SET 1/4 SEC POST. YELLOW OAK 12 S67E 58.08'; YELLOW OAK 18 N12W 63.36'
- 3175.26 HICKORY 18 IN DIA
- 5315.64 SEC CORNER

PG 22 NORTH BETWEEN 15 & 16

- 1013.76 BUR OAK 8 IN
- 2271.72 YELLOW OAK 14 IN
- 2640 SET 1/4 SEC POST BUR OAK 5 IN S89E 4.62'; BUR OAK 8 IN N35W 7.92'
- 3148.2 BUR OAK 20 IN DIA
- 3639.24 BUR OAK 14 IN DIA
- 5280 SET POST COR OF SECS 9,10,15,16 BUR OAK 18 N71W 58.08'; WHITE OAK 20 S75E (103.62' OR 499.62?)
- 1871 COLLINS REMONUMENTATION NOTES

PG 168 NORTH BETWEEN 15 & 16 VARIATION 5-30

2655.18 INTERSECT 1/4 LINE 8.58' EAST OF CORNER. SET 1/4 STONE BY WITNESS TREE. CORRECTED VARIATION 5-18

CONTINUED NORTH VARIATION 5

5317.62 INTERSECT SECTION LINE 21.12' EAST OF CORNER SET STONE FOR CORNER OF 9, 10, 15, 16 BY STUMP AND ROOTS OF WITNESS TREE. CORRECTED VARIATION 4-27 OCT 24, 1871

PG 180 EAST BETWEEN 16 & 21 VARIATION 4-45

231 CREEK

2638.02 INTERSECT 1/4 LINE 4.62' NORTH OF CORNER SET 1/4 STONE IN PLACE OF STAKE AND STONES. CORRECTED VARIATION 4-51

CORRECTED XXRIATION 4-51

10FZ

N-13

6-79-01

U.S.

PUBLIC LAND SURVEY MONUMENT RECORD

For Public Land Survey Corners in:	WI ADMINISTRATIVE CODE A-E 7.08 REQUIREMENT
CORNER CODE INDEX A1 2 3 4 5 6 7 8 9 10 11 12 13 14 15 16 17 18 19 2021 22 23 24 21 18 19 20 1 22 23 24 21 19 19 19 19 19 19 19 19 19 19 19 19 19	ROCK COUNTY WI IF AVAILABLE ROCK COUNTY COORDINATES PERFERRED North Elev East
N 0 0 2 2 2 2 2 2 2 2 2 2 2 2 2 2 2 2 2	Hor. Datum Vert, Datum LATITUDE ELLIPS. H
30 29 28 21 26 25 × 31 32 33 34 35 36	GPS (X) TRAVERSE (X) BASED ON THE FOLLOWING CONTROL:
PLACE MONUMENT SYMBOL AT PROPER LOCATION ON ABOVE INDEX CORNER MONUMENT (a)	WITNESS MONUMENT

Pd TIES FROM VOLS
Pd 143

BEARINGS ARE BASED ON:

							7	2
FIELD	BOOK	PAGE #				SHEET	2_of	
SHOW	A PLAN VIEW	DRAWING D	EPICTING TH	E CORNER	MONUMENT	AND SURRO	UNDING	

PHYSICAL FEATURES, INCLUDING THE EXCAVATION AREA AND DEPTH.
PLANNING & ZONING COMMITTEE ADOPTED THE ABOVE FORM ON 12/2/1982

CONTINUED EAST VARIATION 4-30

5276.7 SECTION CORNER

PG 166

NORTH BETWEEN 21 & 22 VARIATION 5

2648.58 INTERSECT 1/4 LINE 9.9' WEST OF CORNER. SET 1/4 STONE BY STUMPS OF WITNESS TREES CORRECTED VARIATION 5-14

CONTINUED NORTH VARIATION 5

5311.68 SET STONE FOR CORER OF 15,16,21,22 BY WITNESS TREE AND STUMP PG 167 EAST BETWEEN 15 & 22 VARIATION 3-15

2698.74 INTERSECT 1/4 LINE 18.48' NORTH OF CORNER SET 1/4 STONE BY STUMP OF WITNESS TREE CORRECTED VARIATION 3-40

CONTINUED EAST VARIATION 3-18

5404.08 SECTION CORNER

- 1976 BARNES VOL 5 PG 143 SET COR BY PRORATION CORNER FELL IN PATCHED HOLE THAT WAS DUG BY FORMER COUNTY SURVEYOR. REFERENCED SAME.
- 1976 BARNES VOL 5 PG 144 2635.77 TO S 1/4 COR SEC 16, 2695.12 TO S 1/4 COR SEC 15, 2653.08 TO E 1/4 COR SEC 16, & 2661.00 TO E 1/4 COR SEC 21.
- 1976 LEUENBERGER CSM 5 PG 280 ANGLE OF 90-44-40 @ W 1/4 COR SEC 15 FROM SE TO CENTER OF SEC 16.
- 1977 BARNES VOL 5 PG 304 FD PK SET ALUM. MON.
- 1991 LEUENBERGER CSM 18 PG 255 2635.68 TO S 1/4 COR SEC 16.
- 1991 KREBS #11604 ANGLE OF 89-04-38 @ SE COR SEC 16 FROM S 1/4 TO E 1/4 COR SEC 16, 2635.62 TO S 1/4 COR SEC 16, 2653.06 TO E 1/4 COR SEC 16, ANGLE OF 90-45-01 @ E 1/4 COR SEC 16 FROM SE TO CENTER OF SEC 16, & ANGLE OF 90-58-53 @ S 1/4 COR SEC 16 FROM CENTER TO SE COR SEC 16.
- 1998 HOULE #8080 ANGLE OF 92-25-10 @ SW COR SEC 15 FROM W 1/4 TO S 1/4 CORNERS OF SEC 15, ANGLE OF 87-12-02 @ S 1/4 COR OF SEC 15 FROM SW TO CENTER OF SEC 15, ANGLE OF 87-25-07 @ W 1/4 COR SEC 15 FROM CENTER TO SW COR SEC 15, 2695.35 TO S 1/4 COR SEC 15, 2653.15 TO W 1/4 COR SEC 15
- 1998 HOULE CSM 21 PG 391 2653.15 TO W 1/4 COR SEC 15.

FD ALUM. MON.

C) Was the corner restored through acceptance of (1) an obliterated evidence location, or, (2) a found perpetuated location?

ACCEPTED FOUND PERPETUATED LOCATION.

- D) Describe any material discrepancy between the location of the corner as restored or reestablished and the location of that corner as previously restored or reestablished by distance and direction. Show the discrepancy on the plan view drawing under (a), above. Show the distances between the corner as previously restored or reestablished and (1) the corner as restored or reestablished, and (2) to at least 4 of the witness monuments shown on the drawing in (a), above.
- (E) Was the corner reestablished through lost corner proportionate methods? If so, show the method, including the directions and distances to other public land survey corners used as evidence or used for proportioning the corner location.
- I, Donald Barnes, hereby certify that the corner location as identified by the corner code index was determined by me under my direction and control and that this U.S. Public Land Survey Monument Record is correct and complete to the best of my knowledge and belief.

Swald Bornes emboss 6-7901

SHEET 2 OF \$ Z

CORNER CODE N-13

A-E 7.08 REQUIREMENT