

U.S. PUBLIC LAND SURVEY MONUMENT RECORD

For Public Land Survey Corners in:

WI ADMINISTRATIVE CODE A-E 7.08 REQUIREMENT

T. 1 N., R. 11 E

CORNER CODE INDEX

A	2	3	4	5	6	7	8	9	10	11	12	13	14	15	16	17	18	19	20	21	22	23	24	25
B																								
C	6																							
D																								
E																								
F																								
G	1	8	9	10	11	12																		
H																								
I																								
J																								
K																								
L	18	17	16	15	14	13																		
M																								
N																								
O																								
P	19	20	21	22	23	24																		
Q																								
R																								
S	30	29	28	27	26	25																		
T																								
U																								
V																								
W																								
X	31	32	33	34	35	36																		
Y																								
Z																								

NEWARK TWP
ROCK COUNTY WI

IF AVAILABLE
ROCK COUNTY COORDINATES PREFERRED

North _____ Elev. _____

East _____

Hor. Datum _____ Vert. Datum _____

LATITUDE _____ ELLIPS. HT. _____

LONGITUDE _____

GPS (X) _____ TRAVERSE (X) _____

BASED ON THE FOLLOWING CONTROL:

PLACE MONUMENT SYMBOL AT PROPER LOCATION ON ABOVE INDEX

CORNER MONUMENT

WITNESS MONUMENT

(a)

BEARINGS ARE BASED ON:

FIELD BOOK _____ PAGE # _____

SHEET 1 OF 2

SHOW A PLAN VIEW DRAWING DEPICTING THE CORNER MONUMENT AND SURROUNDING PHYSICAL FEATURES, INCLUDING THE EXCAVATION AREA AND DEPTH.

PLANNING & ZONING COMMITTEE ADOPTED THE ABOVE FORM ON 12/2/1982

CORNER CODE G-1

NE534

(B) Describe any record evidence, monument evidence, occupational evidence, testimonial evidence or any other material evidence you considered, and whether the monument was found or placed.

- 1833 MULLETT SEP 4 NORTH ON EAST SIDE SECTION 12
1254 LEAVE MARSH
2640 SET QUARTER SECTION POST BUR OAK 18 N75W 49.5'; BLACK OAK 8 N73E 38.28'
2904 ENTER MARSH
3696 LEAVE MARSH
5280 SET POST CORNER SECTIONS 1 & 12. BLACK OAK 10 N47W 19.8'; BLACK OAK 10 S42W 58.74'. EXCEPT MARSH LAND ROLLING SECOND RATE TIMBER WHITE BLACK AND BUR OAK
- 1871 RUGER VOL 2-65 FD OLD STAKE & STUMP OF N.E. BT. DROVE STAKE DEEP & PUT ON TOP OF IT L.S. 8X6X2 SURROUNDED WITH 4 L.S. USED TO SUBDIVIDED SEC 12 AVON. VAR 6-39 2664.42 TO SW COR SEC 7.
- 1871 COLLIN'S PG 206 NORTH ON WEST LINE OF 7 VARIATION 6
2664.42 SET 1/4 STONE BY ROOTS OF WITNESS TREES.
CONTINUED NORTH VARIATION 6-30
5333.46 SET STONE FOR CORNER OF 6 & 7 BY WITNESS TREE AND STUMP.
- 1963 BATTERMAN VOL 4 PG 163 FD CUT STONE MON. REFERENCED SAME.

FD LARGE NAIL & REFERENCE PIPES. TWO OF THE REFERENCE PIPES DID NOT CHECK AND THE DISTANCES DID NOT CHECK BETWEEN THE THREE PIPES. NAIL IS 3.8' SOUTH OF NORTH PVMT EDGE.

C) Was the corner restored through acceptance of (1) an obliterated evidence location, or, (2) a found perpetuated location?

SINCE THE REFERENCE PIPES WERE SET IN 1963 AND THE DIFFERENCE IN THE DISTANCE BETWEEN THEM VARIED SLIGHTLY, I ACCEPTED THE FOUND NAIL. CORNER IS ON LINE WITH THE CENTER OF PVMT PROJECTED FROM THE EAST & 4.5' NORTH OF THE CENTER OF PVMT AT THE LOCATION.

D) Describe any material discrepancy between the location of the corner as restored or reestablished and the location of that corner as previously restored or reestablished by distance and direction. Show the discrepancy on the plan view drawing under (a), above. Show the distances between the corner as previously restored or reestablished and (1) the corner as restored or reestablished, and (2) to at least 4 of the witness monuments shown on the drawing in (a), above.

(E) Was the corner reestablished through lost corner proportionate methods? If so, show the method, including the directions and distances to other public land survey corners used as evidence or used for proportioning the corner location.

I, Donald Barnes, hereby certify that the corner location as identified by the corner code index was determined by me under my direction and control and that this U.S. Public Land Survey Monument Record is correct and complete to the best of my knowledge and belief.

 seal

7-20-01

emboss

sheet 1 of 2

CORNER CODE **G-1**


A-E 7.08 REQUIREMENT

W 1/4 COR
SEC 7
T1N R11E
NEWARK TWP

XXXXXXXXXXXXXXXXXXXX

3/4X24
REROD/CAP

S73-16-38E 62.22

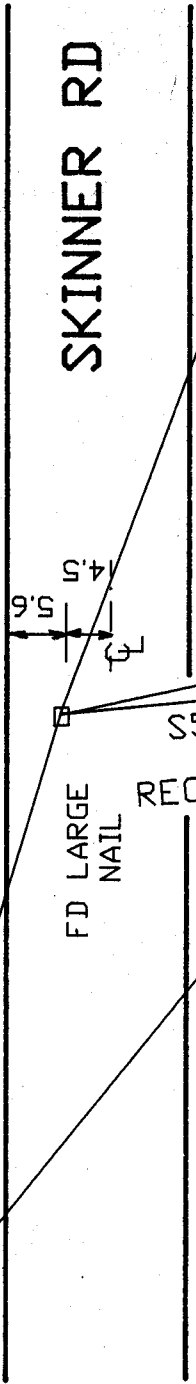

SKINNER RD

FD LARGE
NAIL

REC

S5-40-22E
32.98
33.00

S51-05-55E

4.3' LOWER
THAN PVMT

FD 2" PIPE
1' ABOVE
GROUND

REC DISTANCES
ARE FROM VOL 4 PG 163
1963

OBSERVATION SHEET #534

S12-27-47E
REC 48.53
48.53

FD 1" PIPE

S26-20-25E 16.26
REC 16.77


S69-28-45E 76.97
76.85

LARGE OAK

FD 1" PIPE
7.4' LOWER
THAN PVMT

N71-36-51E 64.81
64.62

LARGE OAK
6.3' LOWER
THAN PVMT.

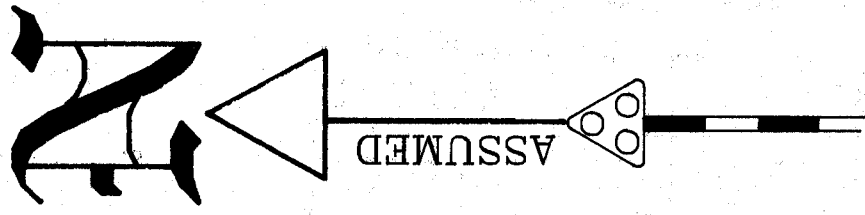

NOT TO SCALE

Daniel Barnes
EMBOSSED
SEAL

7-20-01

G-1