Paper weight-110# (minimum)

Black nonfading ink required

U.S.

## PUBLIC LAND SURVEY MONUMENT RECORD

For Public Land Survey Corners In:	WI ADMINISTRATIVE CODE A-E 7.08 REQUIREMENT
$T. \cancel{\neq} N. R. \cancel{//} E. 4th P.M.$	REV 10/23/2004 USMONREC.DWG
CORNER CODE INDEX	Part = 0
A 1 2 3 4 5 6 7 8 9 10 11 12 13 14 15 16 17 18 19 20 21 22 23 2	PORTER TWP
C C C C	B ROCK COUNTY WI
D	D IF AVAILABLE
E F	E ROCK COUNTY COORDINATES PERFERRED
G A S S S	- $G$
H J	H North Elev
	K East
M N	M N Hor. Datum Vert. Datum
	$egin{array}{cccccccccccccccccccccccccccccccccccc$
RS	R - S LONGITUDE
	T
V	V NAD83(91)NETWORK ADJ. YR
x 3 3 3 3 3	W X GPS (X) TRAVERSE (X)
	T DACED ON THE
1 2 3 4 5 6 7 8 9 10 11 12 13 14 15 16 17 18 19 20 21 22 23 24 PLACE MONUMENT SYMBOL AT PROPER LOCATION ON ABOVE INDEX	125 TOLLOWING CONTROL.
A CORNER MONTH	) WITNESS MONUMENT
(a)	WITNESS MONUMENT

BEARINGS ARE BASED ON:

FIELD BOOK \_\_\_\_\_ PAGE # \_\_\_\_\_ OF SHOW A PLAN VIEW DRAWING DEPICTING THE CORNER MONUMENT AND SURROUNDING PHYSICAL FEATURES, INCLUDING THE EXCAVATION AREA AND DEPTH.
PLANNING & ZONING COMMITTEE ADOPTED THIS FORM ON 12/2/1982

#### P0572

#### N1/4CORSEC24

(B) Describe any record evidence, monument evidence, occupational evidence, testimonial evidence or any other material evidence you considered, and whether the monument was found or placed.

1833	(DCT 29 NOV 4) HARRISON EAST ON RAND BET SECS 13 &	
	24 T4N R11E 4 <sup>TH</sup> MER	

- 144.54 CATFISH CRK RIGHT BANK SET GUIDE POST CRS S.E.
- 290.4 LEAVE CAT FISH SET MEANDER GUIDE POST ON LEFT BANK
- 2640 TEMPY 1/4 SEC COR
- 3019.5 TRAIL NORTH
- 3321.78 NORTHERN BEND OF CATFISH SET G.P
- 4224 LEAVE CAT FISH SET G.P. CRS SE
- 4504.5 CAT-FISH CRS NE SET GUIDE P
- 4711.08 LEAVE CAT-FISH SET GUIDE P
- 5313 INT. E BDY 3.3?(330'?) N DF P LAND ROLLING  $2^{ND}$  RATE WITH RED BURR & WO TIMBER
  - COR. WEST BET SECS 13 & 24

    SET M.P. ON RIGHT BANK OF CATFISH RED 0 10

    S41E 75.9'
- BOB.5 LEAVE CATFISH SET MEAN. P RED D 12 N45W 405.9'?
- 1089 BEND OF CAT-FISH SET MEAN, P. BURR O 10 NORTH 264'
- 1993.2 LEAVE CAT-FISH SET MEAN P. RED 0 12 N33E 39.6'?
- 2656.5 QUARTER SEC COR {W.O. 10 S42E 47.52' W.O. 12 S80W 29.04'
- 5022.6 LEFT BANK OF CAT-FISH SET MEAN P. W.O.
- 5168.46 LEAVE CATFISH SET MEAN. P. WO. 15 N82W 77.88'
  BURR O 20 53E 77.88'
- 5313 SEC COR.

601.92

### SEARCHED & FOUND NOTHING. DID NOT FIND ANY FENCE LINE.

C) Was the corner restored through acceptance of (1) an obliterated evidence location, or, (2) a found perpetuated location?

#### NO

- D) Describe any material discrepancy between the location of the corner as restored or reestablished and the location of that corner as previously restored or reestablished by distance and direction. Show the discrepancy on the plan view drawing under (a), above. Show the distances between the corner as previously restored or reestablished and (1) the corner as restored or reestablished, and (2) to at least 4 of the witness monuments shown on the drawing in (a), above.
- (E) Was the corner reestablished through lost corner proportionate methods? If so, show the method, including the directions and distances to other public land survey corners used as evidence or used for proportioning the corner location.

YES. SET REFERENCE MONUMENTS, BUT DID NOT SET COR MONUMENT. FIELD WAS PLANTED & NOT ACCESSABLE.

I, **Donald Barnes**, hereby certify that the corner location as identified by the corner code index was determined by me under my direction and control and that this U.S. Public Land Survey Monument Record is correct and complete to the best of my knowledge and belief.


SHEET 1 OF 2

Linboss Peuros Apr 24 2010

CORNER GODE N-23

A.E. 7.08 REQUIREMENT

# PORTER TWP TARILE

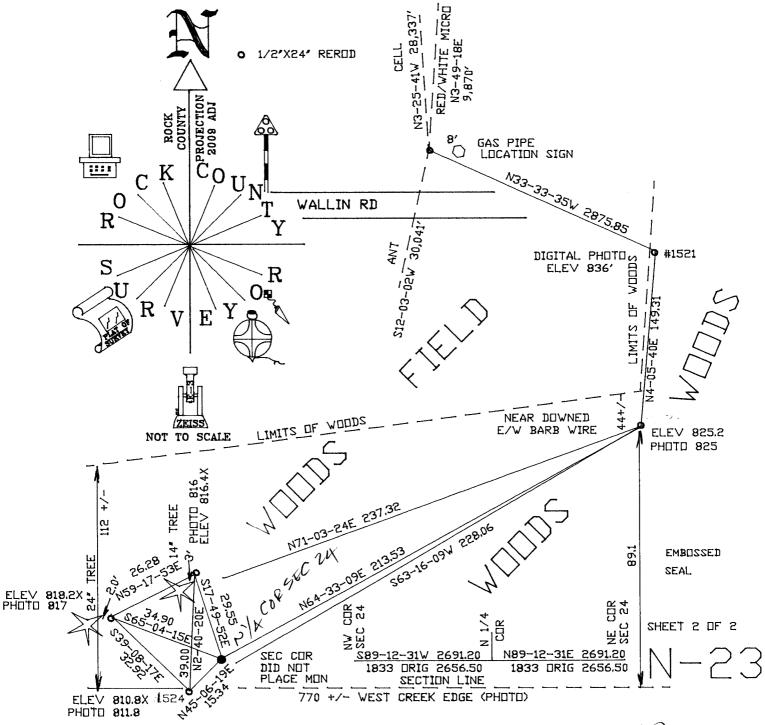

Perolo Frances Apr. 28 2010