Paper weight-110# (minimum)

Black nonfading ink required

U.S. LAND **PUBLIC** SURVEY MONUMENT RECORD


For Public Land Survey Corners In:

WI ADMINISTRATIVE CODE A-E 7.08 REQUIREMENT

REV 10/23/2004

T. 4 N. R. 11 E. 4th P.M.

CORNER CODE INDEX

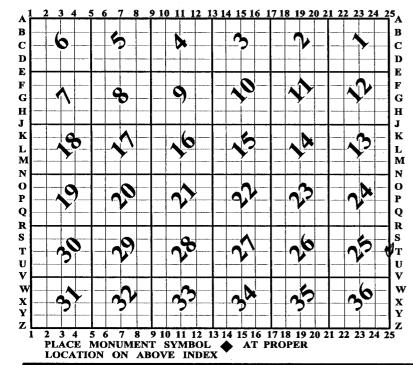

PORTER TWP **ROCK COUNTY WI**

IF AVAILABLE ROCK COUNTY COORDINATES PERFERRED

NorthElev	v					
East						
Hor. Datum Vert. Da	atum					
LATITUDE	_ ELLIPS. HT.					
LONGITUDE	_					
NAD83(91)NETWORK ADJ. YR						
GPS (X) TRAVERSE	(X)					
BASED ON THE FOLLOWING	G CONTROL:					

♦ CORNER MONUMENT

WITNESS MONUMENT

BEARINGS ARE BASED ON:_

(a)

FIELD BOOK PAGE # SHOW A PLAN VIEW DRAWING DEPICTING THE CORNER MONUMENT AND SURROUNDING PHYSICAL FEATURES, INCLUDING THE EXCAVATION AREA AND DEPTH. PLANNING & ZONING COMMITTEE ADOPTED THIS FORM ON 12/2/1982

P0600 E1/4CORSEC25

(B) Describe any record evidence, monument evidence, occupational evidence, testimonial evidence or any other material evidence you considered, and whether the monument was found or placed.

1833 (SEP) MULLETT & BRINK NORTH ON EAST SIDE SECTION 25

T4N R11E 4TH MERIDIAN MT.

2640 SET QUARTER SECTION POST BUR DAK 6 N34W B2.5' WHITE DAK 12 N31E 126.72

2772 LEAVE PRAIRIE AND ENTER WOODLAND

5280 SET POST CORNER SECTIONS 24 & 25 BUR OAK 10 S35W 135.3' BUR OAK 10 N76E 168.3'

LAND ROLLING SECOND RATE LAST HALF THINLY TIMBERED WITH WHITE BLACK & BUR DAK ELM AND

TIMBERED WITH WHITE BLACK & BUR DAK ELM AND WHITE MAPLE THE REST PRAIRIE

1854 TWP RD REC PORTER TWP BK 1 PG 6 BEGINNING AT THE 1/4
POST ON THE WEST LINE OF SEC 19 T4N R12E [STH 184];

- POST ON THE WEST LINE OF SEC 19 T4N R12E [STH 184];
 THENCE RUNNING SOUTH ON THE SECTION LINE 1337.82';
 THENCE EAST 446.82'; THENCE S18 ½E 396'; THENCE S3W
 264' TO RED OAK TREE; THENCE S17 ¾W 264' TO BURR OAK;
 THENCE S1E 764.94'; THENCE S11W 502.92' TO BURR OAK
 TREE; THENCE S6 ¾W 326.04'; THENCE S17E 1158.3';
 THENCE S30 ¾W 741.84'; THENCE S41 ¾W 1247.4' TO THE
 WEST LINE OF T4N R12E (THENCE SOUTH ON THE TOWN LINE
 766.92', THENCE S42 ½W 924'; [SEC 30 FULTON] THENCE S3
 ¼W ? CHAINS; THENCE S32 ½E 1013.1' TO THE W. LINE OF
 T4N RF12E; THENCE S. ON THE TOWN LINE 4746.06' TO THE
 SW COR OF SEC 31 OF T4N R12E)
- 1977 BARNES VOL 5 PG 264 & 265 SET ALUM. MON. DUG & FD NOTHING. IF COR WAS DECLARED LOST AND SET ON A STRAIGHT BETWEEN THE SE COR SEC 25 & THE E 1/4 COR SEC 24 AT SINGLE PROPORTIONATE DISTANCE, THE FOLLOWING RELATIONSHIP WOULD EXIST. USED OCCUPATION BECAUSE OF THE LARGE DISTANCE BETWEEN THE EXISTING CORNERS. SHOWS MON 1.6' NORTH OF FENCE INT. & ON LINE WITH N/S FENCE (WESTERLY FENCE TO THE SOUTH). THE LOST POSITION IS 7' NORTH OF E/W FENCE & 12.9 EAST OF N/S FENCE. REF. SAME. REFERENCED SAME. PORTER TWP FB #1 PG 52.
- 1977 BARNES VOL 5 PG 267 2650.1 TO SW COR SEC 30 & 2611.9'
 TO NW COR SEC 30
- 1981 COMBS CSM VOL 10 PG 410 E $^{1}\!\!\!/_4$ COR SEC 25 PORTER TWP ALUM. ANGLE 89-33-00 @ SE COR SEC 25 FROM S $^{1}\!\!\!/_4$ COR SEC 25 TO E $^{1}\!\!\!/_4$ COR SEC 25
- 1982 WIDOT VOL 6 PG 240 & 271 & #6625, 11544, 11545, 11546
 FOLLOWING INFORMATION WAS COPIED FROM STH PLANS
 PROJECT #5972-01-22 SHEET 4.2 ALUM. MON 285,999.98;
 2,233,285.31
- 1982 WIDOT #11544 PROJECT 5972-01-22 SHEET 4.2 CALLS FOR ALUM MON & NAD27 COORDINATES OF N/S 285,999.98'; 2,233,285.31'. INVERSE OF SOO-52-20E 2649.94' TO SW COR SEC 30.
- 1983 BARNES R-1 2650.37 TO SW COR SEC 19
- 2000 RIESOP CSM VOL 23 PG 340 E $\frac{1}{4}$ COR SEC 25 ALUM. 2649.89 TO SE COR SEC 25 PORTER TWP
- 2003 LATHROP CSM 23 PG 440 FD ALUM. NORTH TO ALUM @ NE COR SEC 25.

SHEET 1 OF 2 CORNER CODE T-25

Duald Baines 3-30-2009

PO600 E1/4CORSEC25

FD	ALUM.	MON.,	REF.	PIPES,	&	CARSONITE	POST	$\square N$	sw	SIDE
OF	MON.									

C) Was the corner restored through acceptance of (1) an obliterated evidence location, or, (2) a found perpetuated location?

ACCEPTED FD MON.

- D) Describe any material discrepancy between the location of the corner as restored or reestablished and the location of that corner as previously restored or reestablished by distance and direction. Show the discrepancy on the plan view drawing under (a), above. Show the distances between the corner as previously restored or reestablished and (1) the corner as restored or reestablished, and (2) to at least 4 of the witness monuments shown on the drawing in (a), above. NONE
- (E) Was the corner reestablished through lost corner proportionate methods? If so, show the method, including the directions and distances to other public land survey corners used as evidence or used for proportioning the corner location. NO

I, Donald Barnes, hereby certify that the corner location as identified by the corner code index was determined by me under my direction and control and that this U.S. Public Land Survey Monument Record is correct and complete to the best of my knowledge and belief

Emboss 3_30-2009

SHEET 2 OF 2

CORNER CODE T-25